


Section 33 Township 33 Range 34W

Well No. #1 Alexander

Company Penhandle Eastern

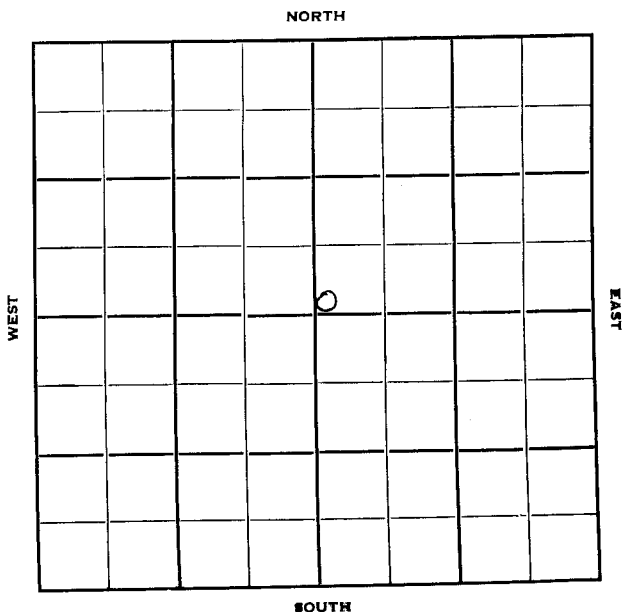

Sec. 33 Twp. 33 R. 34-W ✓

Well No. #1 Alexander Farm

Panhandle Eastern Company

Cpnt- Moran Drlg


Hugoton Pool

Ft. from N. Line

100 Ft. from S. Line

Ft. from E. Line

100 Ft. from W. Line

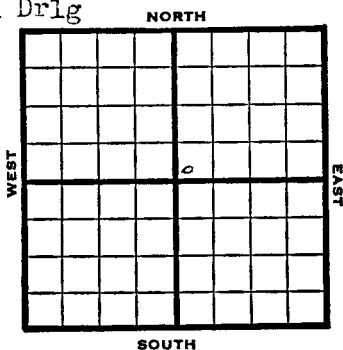

SW NE

REPORT	
1949	Elev 2913'
10/5	Location
10/12	"
10/19	10"@ 673' TD 2619' 7"@ 2608'
10/26	TD 2764'
11/1	186' of 5" perf Liner @ 2764' 17000 acid
11/9	TD 2764' 7"@ 2608' 186' of 5" Liner @ 2764' 17000 acid 19,304,000 Gas 414# R Pr. Comp
COMPLETED	

Map No. _____ Sec. 33 Twp. 33 R. 34W

Well No. 1 Alexander

Panhandle Eastern Company

Meran Drilling Contractor

SW NE

**FIRST REPORT
SECTION PLAT**

		o	

_____ Ft. from N. Line

100 Ft. from S. Line

_____ Ft. from E. Line

100 Ft. from W. Line

Seward County

Location X

Rig up _____

Drilling and Remarks:

RECORD

Cased _____ in., _____ ft.

Sand _____

Gas _____

Oil _____

Total Depth _____

PRODUCTION

1st 24 hrs. Nat. _____

1st 24 hrs. after shot _____

Gas _____ Cu. Ft.

Dry Hole _____

Abandoned _____

Date

OCT 5 1943 19

S. J. LEWIS Scout

Map No. _____ Sec. 33 Twp. 33 R. 34W

Well No. 1 Alexander

Panhandle Eastern Company

COMPLETE

Contractor

SWNE


E 12913
SECTION PLAT

_____ Ft. from N. Line

100 Ft. from S. Line

_____ Ft. from E. Line

100 Ft. from W. Line

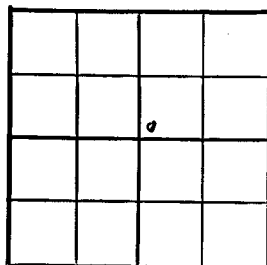

Seward County

Location _____

Rig up _____

Drilling and Remarks:

7" C 2605.

186' x 10' line C

2764

17000 acid

19,304,000 Gas

*414 * R 12*

RECORD

Cased _____ in., _____ ft.

Sand _____

Gas _____

Oil _____

Total Depth 2764

PRODUCTION

1st 24 hrs. Nat. _____

1st 24 hrs. after shot _____

Gas _____ Cu. Ft.

Dry Hole _____

Abandoned _____

Date

NOV 9 1949

19

S. J. LEWIS

Scout