


KANSAS Stevens

FORM 51 5M PETROL

Section 33 Township 33 Range 38N

Well No. 1 Morgan

Company Panhandle Eastern

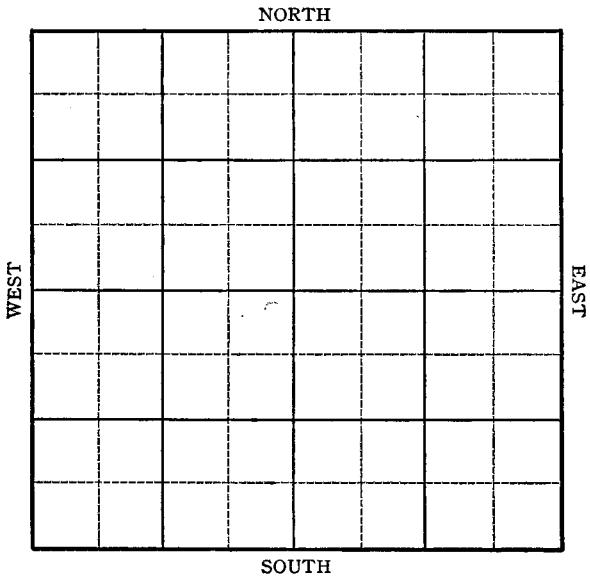

KANSAS Stevens County

Sec. 33 Twp. 33 R. 38W

Well No. #1 Morgan Farm

Panhandle Eastern Company


Hugoton

100 Ft. from N. Line

Ft. from S. Line

100 Ft. from E. Line

Ft. from W. Line

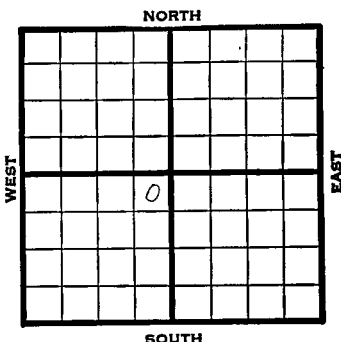

NE SW Elev. 3204

REPORT

1945

7/11 Drlg. 635

7/19 13" @ 557

Drlg. 2080

7/26 7" @ 2551

TD 2555' RUST

8/1 " " "

8/8 " " "

8/15 " " "

8:22 " " "

8/29 " " "

9/5 " " "

9/12 " " "

9/19 " " "

9/26 " " "

10/3 " " "

10/10 " " "

10/17 " " "

10/24 " " "

10/31 " " "

11/7 " " "

11/14 " " "

11/21 " " "

11/28 " " "

12/5 " " "

12/12 Drlg. 2588

12/20 T.D. 2772' 245' of 5" perf liner at 2772'

12/29 " "

OVER

1946

1/9 7" @ 2554.
245' of 5" liner @ 2772
13,500 acid.
TD 2772
16,558,000 Gas.
398# R Pr.

COMPLETED

KANSAS

Kansas Pool Name HugotonMap No. 100 Sec. 33 Twp. 33 R. 38WWell No. 1 MorganPanhandle Eastern

Company


COMPLETED

Contractor

E. J. 3204

NE SW

SECTION PLAT

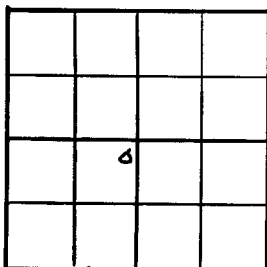100 Ft. from N. Line Ft. from S. Line100 Ft. from E. Line Ft. from W. Line

Stevens County

Location Rig up

Drilling and Remarks:

7' @ 2554245' 4" @ 10" line@ 279218500 seal16,555,800 Gas398 R/R

RECORD

Cased in., ft.Sand Gas Oil Total Depth 2722

PRODUCTION

1st 24 hrs. Nat. 1st 24 hrs. after shot Gas Cu. Ft.Dry Hole Abandoned

Date

JAN 9 1946 19S. J. LEWIS Scout

KANSAS Kansas Pool Name HugotonMap No. 21 Sec. 33 Twp. 33 R. 38WWell No. 1 MorganPanhandle Eastern CompanyFIRST REPORT Contractor

NE SW

SECTION PLAT

100 Ft. from N. Line Ft. from S. Line100 Ft. from E. Line Ft. from W. Line

Stevens CountyLocation Rig up

Drilling and Remarks:

635'

RECORD

Cased in. ft.Sand Gas Oil Total Depth

PRODUCTION

1st 24 hrs. Nat. 1st 24 hrs. after shot Gas Cu. Ft.Dry Hole Abandoned

Date

JUL 1 1 1945

19

S. J. LEWIS Scout