

KANSAS

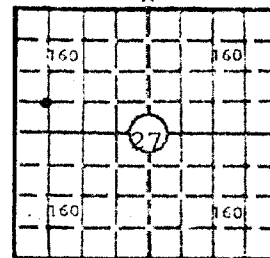
WELL COMPLETION REPORT AND
DRILLER'S LOG

33

S. 27 T. 33 S. 34 R. 34 W

Loc. C SW NW

County Seward

640 Acres
NLocate well correctly
2915'

Elev.: Gr.

DF 2916' KB 2927'

No. 15 — 175 — 20,474
County Number

Operator

Anadarko Production Company

Address

P. O. Box 351, Liberal, Kansas 67901

Well No.

1

Lease Name

GUTTRIDGE "F"

Footage Location

1980 feet from (N) line

660 feet from (E) (W) line

Principal Contractor

Lohmann-Johnson

Geologist

Mr. Joe Blair

Spud Date

7/5/80

Date Completed

8/6/80

Total Depth

6376'

P.B.T.D.

6108'

Directional Deviation

not applicable

Oil and/or Gas Purchaser

Cimarron River System

CASING RECORD

Report of all strings set—surface, intermediate, production, etc.

Purpose of string	Size hole drilled	Size casing set (in O.D.)	Weight lbs/ft.	Setting depth	Type cement	Sacks	Type and percent additives
Surface	12-1/4"	8-5/8"	24#	1687	Pozmix Common	600 200	4% gel 2% CaCl 3% CaCl
Production	7-7/8"	4-1/2"	10.5#	6142	Lite-wate SS Pozmix	100 125	.5% CFR-2 .5% CFR-2

LINER RECORD

PERFORATION RECORD

Top, ft.	Bottom, ft.	Sacks cement	Shots per ft.	Size & type	Depth interval
			2	.46	6008-6018'

Size	Setting depth	Packer set at
2-3/8	5980'	--

ACID, FRACTURE, SHOT, CEMENT SQUEEZE RECORD

Amount and kind of material used	Depth interval treated
A/1000 gal 15% MCA + 25 BS	6008-6018'
A/F 8000 gal Mod 202 + 800 gal 50# Versa-gel + 1000 SCF CO2/BBL	6008-6018'

INITIAL PRODUCTION

Date of first production		Producing method (Flowing, pumping, gas lift, etc.)			
SI for Pipeline		Flowing			
RATE OF PRODUCTION PER 24 HOURS	Oil	Gas	Water	Gas-oil ratio	
	bbls.	800 MCF	bbls.	CFPS	
Disposition of gas (vented, used on lease or sold)			Producing interval(s)		
To be sold			6008-6018'		

INSTRUCTIONS: As provided in KCC Rule 82-2-125, within 90 days after completion of a well, one completed copy of this Drillers Log shall be transmitted to the State Geological Survey of Kansas, 4150 Monroe Street, Wichita, Kansas 67209. Copies of this form are available from the Conservation Division, State Corporation Commission, 245 No. Water, Wichita, Kansas 67202. Phone AC 316-522-2206. If confidential custody is desired, please note Rule 82-2-125. Drillers Logs will be on open file in the Oil and Gas Division, State Geological Survey of Kansas, Lawrence, Kansas 66044.

Operator Anadarko Production Company		DESIGNATE TYPE OF COMP.: OIL, GAS, DRY HOLE, SWDW, ETC.:
Well No. 1	Lease Name GUTTRIDGE "F"	GAS
S 27 T 33S R 34W E W		

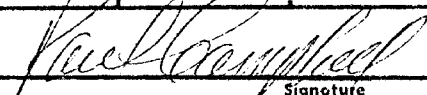
WELL LOG

Show all important zones of porosity and contents thereof; cored intervals, and all drill-stem tests, including depth interval tested, cushion used, time tool open, flowing and shut-in pressures, and recoveries.

SHOW GEOLOGICAL MARKERS, LOGS RUN,
OR OTHER DESCRIPTIVE INFORMATION.

FORMATION DESCRIPTION, CONTENTS, ETC.	TOP	BOTTOM	NAME	DEPTH
Surface and Sand	0'	630'	LOGS:	
Redbed	630'	1070'	Schlumberger	
Sand	1070'	1306'	Compensated Neutron-Formatic	
Redbed and Sand	1306'	1680'	Density	
Anhydrite	1680'	1690'	Dual Induction-SFL	
Shale	1690'	3100'		
Lime and Shale	3100'	3310'		
Shale	3310'	3757'		
Lime and Shale	3757'	6376'		

USE ADDITIONAL SHEETS, IF NECESSARY TO COMPLETE WELL RECORD.

Date Received	 Signature Paul Campbell, Division Production Manager Title September 19, 1980 Date
---------------	--