


WELL NAME AND NUMBER

GUTTRIDGE "A" No. 3

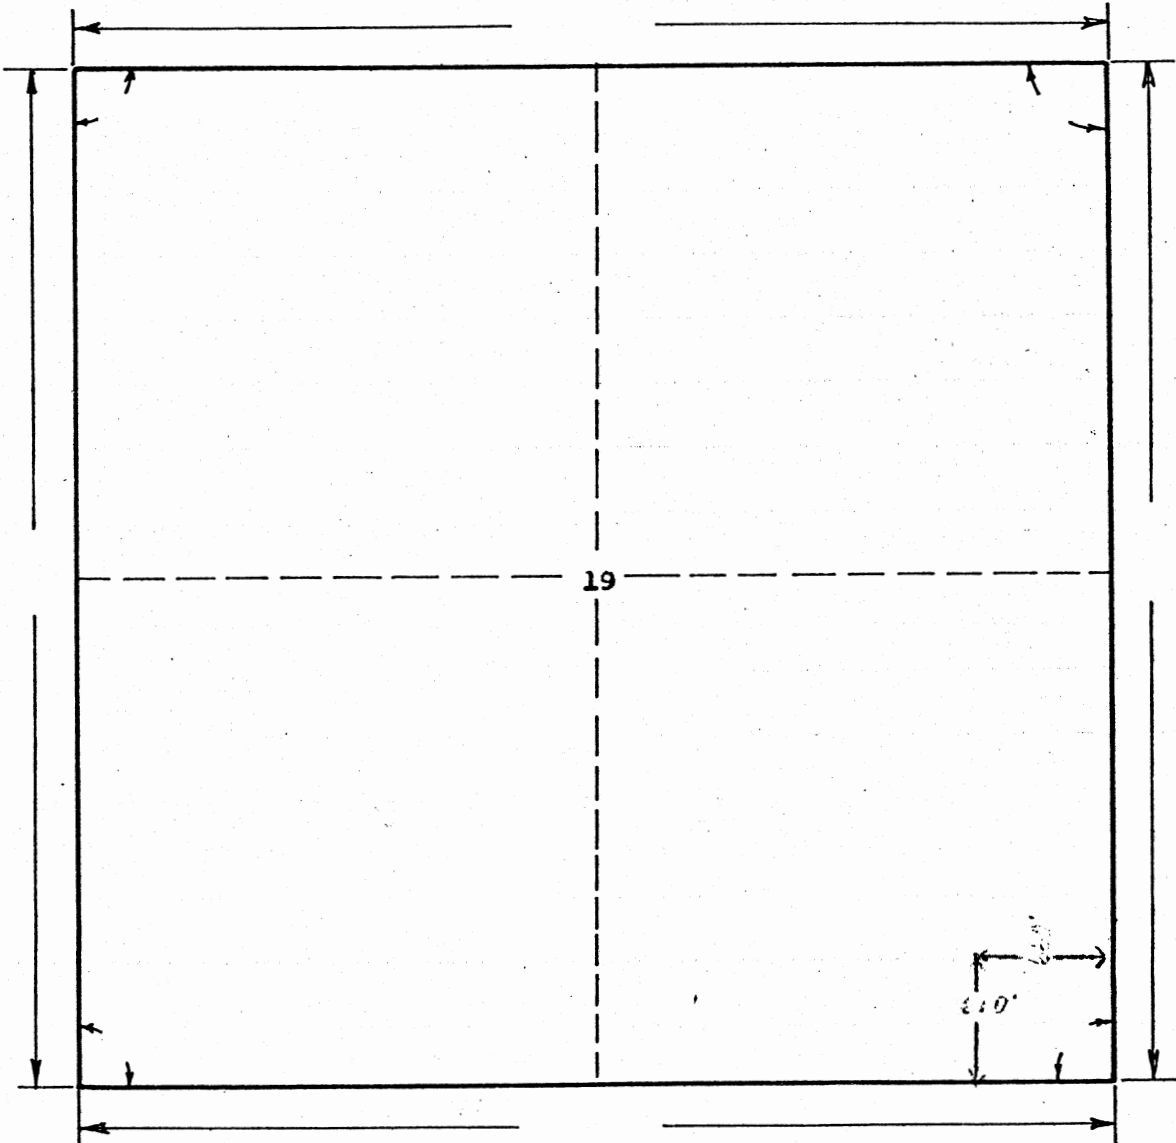

SECTION 19 TOWNSHIP 33S RANGE 34W COUNTY Seward STATE Kansas

BLOCK _____ SURVEY _____

FOOTAGES _____

ELEVATION _____

DATE _____, 19 _____

DESCRIBE TERRAIN _____

SCALE 1 INCH = 1000 FEET

SURVEYOR _____