


Township 33 S, Range 33 + 34 W, County Seward, State Kansas

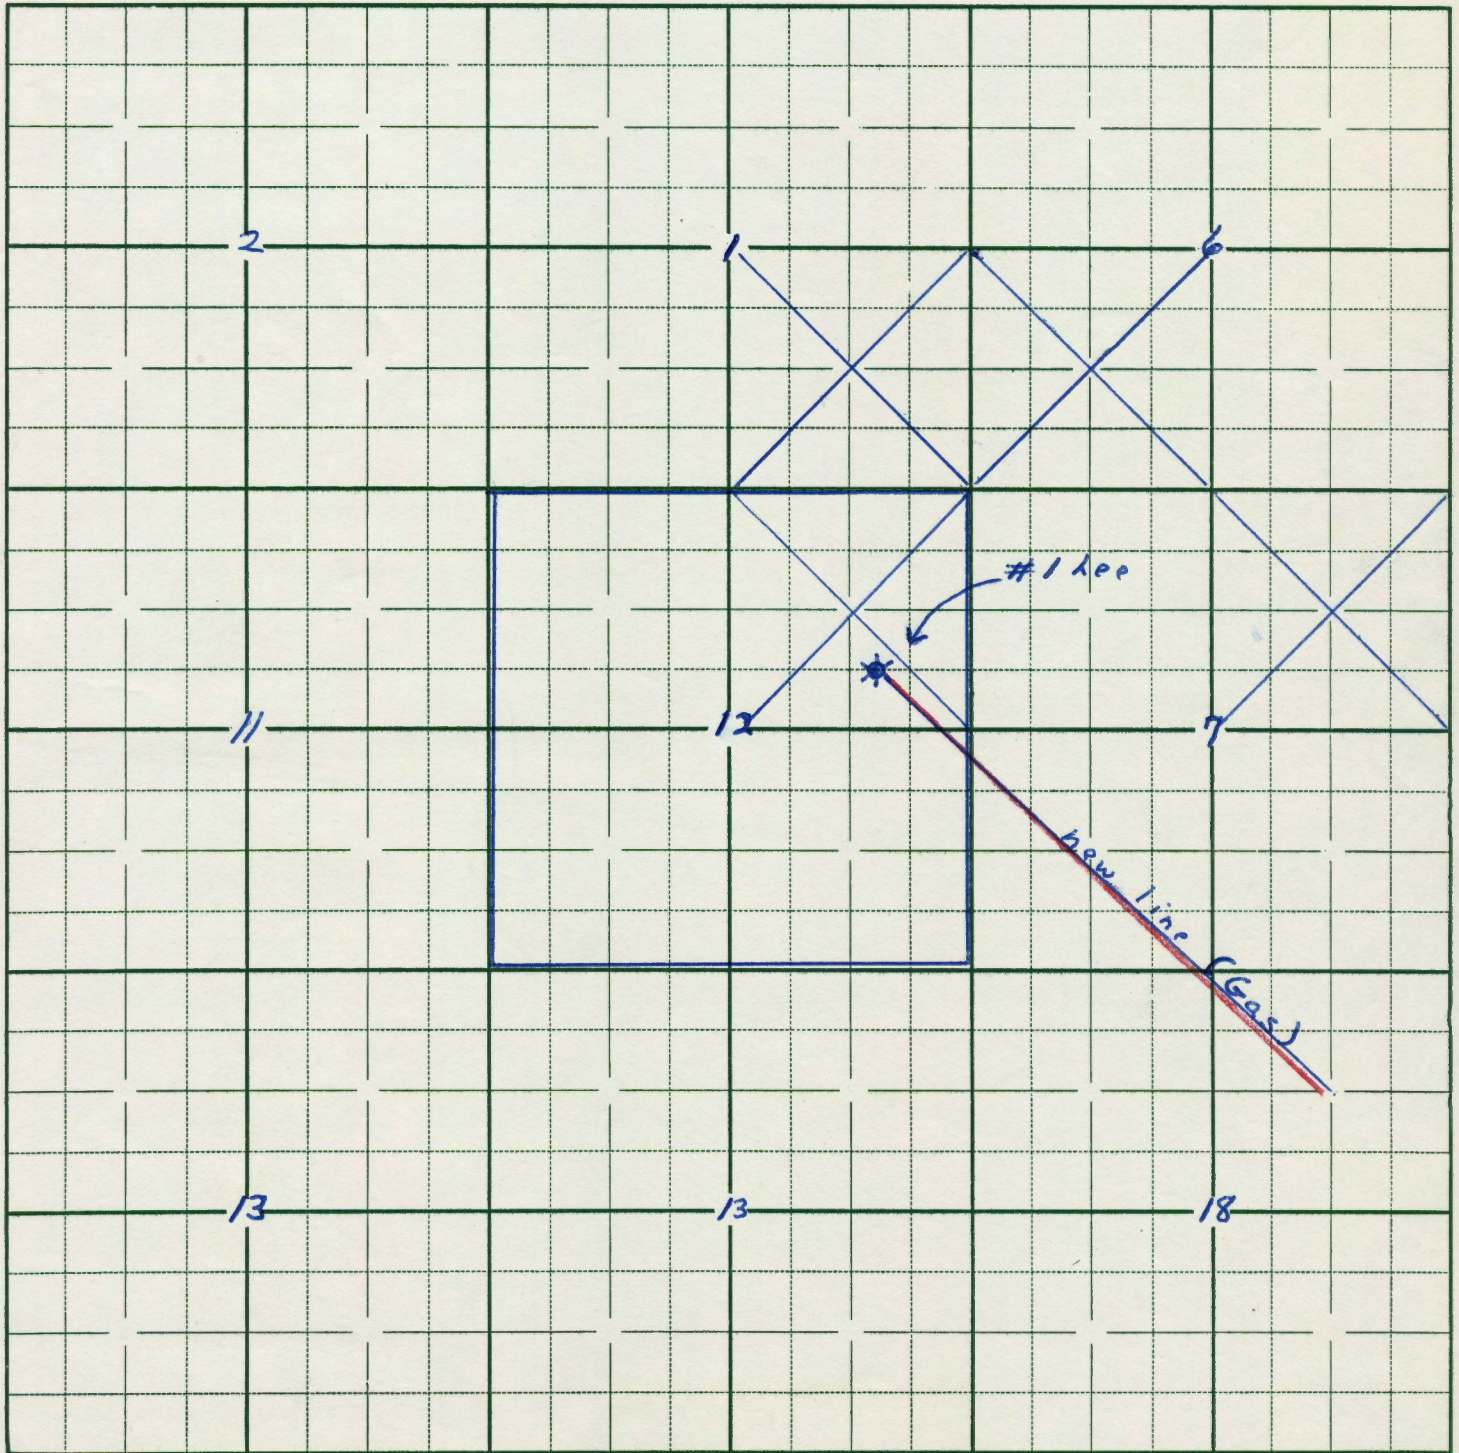

Sec 12 Twp. 33S Rgp. 34W  
Seward Co. Kans