

DX 78-1

Morton

KANSAS

34

33


41W

Section _____ Township _____ Range _____

Well No. #1-34 Harmon

Company P E P L & Champlin

NORTH

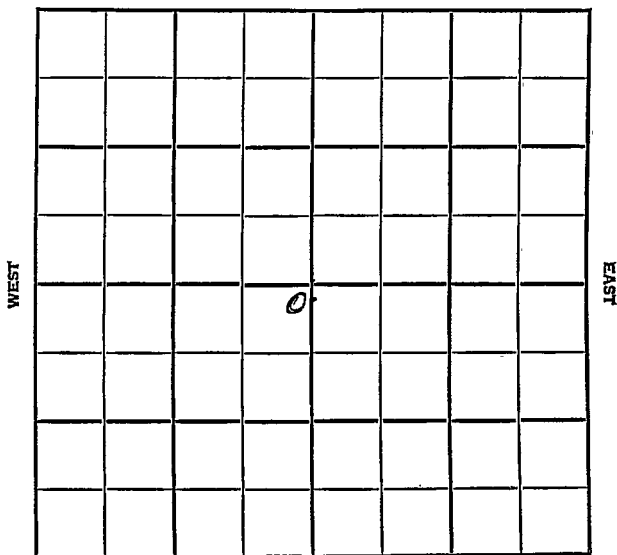

SOUTH

County <u>Morton</u>				Elev.	Co.
Sec. <u>34</u>	Twp. <u>33</u>	Rge. <u>41W</u>			
Company <u>P.E.P.L. & Champlin</u>					
Farm Name <u>Harmon</u>				No. <u>1-34</u>	

TOPS	DEPTH	LOG	DATUM	Loc. in Sec.
Anh.				100' S & 100'
Tr.				W of Cen. of
H.				SEC.
Tr.				
Dg.				
Bl.				
L.				Geol.
K.C.				Contr.
B.K.C.				
Ce.				
C.				
M.				Pool
M.				Hugoton Pool
K.				
Mz.				
Mo.				
V.				
S.				
S.				
A.				
R.				
PE.				
G.				
T.D.				

FIRST REPORT
 OCT 24 '56

Date Comm. spd. 10-20-567" @ 654 w/275, WOC 2300' tst

VOM

.2.51

57

Co.

County Morton Elev. 3371
 Sec. 34 Twp. 33 Rge. 41W
 Company P.F.P.L. & Champlin
 Farm Name Harmon No. 1-34

TOPS	DEPTH	LOG	DATUM	Loc. in Sec.
Anb.				
Tp. <u>Kri</u>		<u>2145</u>		<u>100' S & 100'</u>
H. <u>Wfd</u>		<u>2203</u>		<u>W. of Cen. of</u>
Tr.				<u>Sec.</u>
Dg.				
Bl.				
L.				Geol. _____
K.C.				Contr. _____
B.K.C.				
Ce.				
C.				
M.				Pool _____
M.				
K.				<u>Hugoton Pool</u>
Mz.				
Me.				
V.				
S.				
S.				
A.				
R.				
Pe.				
G.				
Tp.	<u>2285</u>	<u>2268</u>		

COMPLETE
 DEC 26 '56

Loc.

No.

Sec.

T.

R.

Date Comm. Spd. 10-20-567" @ 654 w/275, WOC 2300' tst OCT 31 '56Twist off @ 1682 SKIDRig 25' south 240NOV 7 '56 Spd 10-29-56 85/8647/300 9 1/2 @ 2283/300NOV 13 '56 25/8 MLC NOV 21 '56 CO 226816/2205-09 16/2214-18 11 9a672 MCF/3 9a 672 MCF PB2196 28/2154-61 12/2166-69

20/2172-77 16/2184-88

11) 9a 713 MCF 13 9a 1.62

MCF FRAC 9a 3.195 MCF NOV 28 '56

Co. 11) 9a 3.345 MCF

1 1/2 TBG to 2208 DEC 5 '56 ✓ DEC 12 '56

DEC 19 '56 DEC 6 '56 5t. Deliv. 1st

811 MCF. RP 398 #