

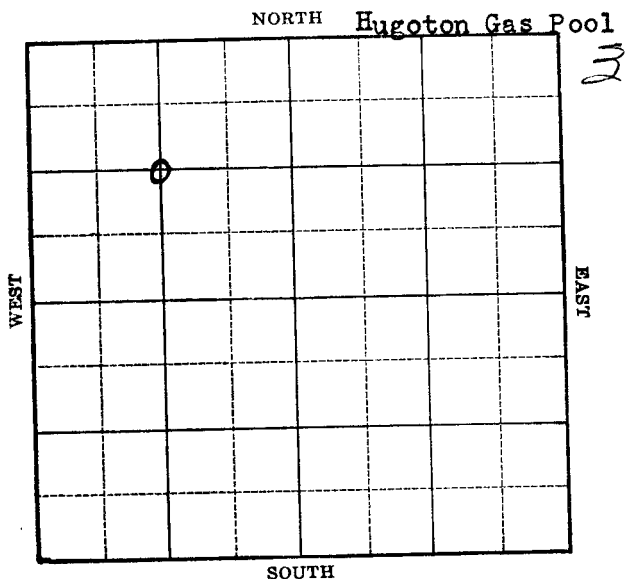
Stevens

KANSAS

Section 34 Township 33 Range 37-W

Well No. #1 Brubaker

Company Stevens County Oil & Gas



Stevens KANSAS

Map No. NM Sec. 34 Twp. 33 R. 37WWell No. 1 Brubaker

Stevens County Oil & Gas Company

COMPLETED

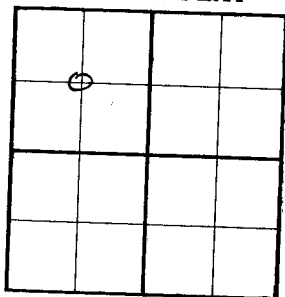
Contractor

C NW

SECTION PLAT

1320 Ft. from N. Line Ft. from S. Line Ft. from E. Line1320 Ft. from W. Line

HUGOTON GAS POOL

Location Rig up

Drilling and Remarks:

3 1/4 M gas - No oil8000 Acid

RECORD

Cased 7 in., 2580 ft.Sand Gas Total Depth 2777

PRODUCTION

1st 24 hrs. Nat. 1st 24 hrs. after shot 'Gas Cu. Ft.Dry Hole Abandoned

Date

FEB 15 1939 19

H. D. Hatfield

Scout

Stevens

KANSAS

Map No. NM Sec. 34 Twp. 33 R. 37WWell No. 1 BrubakerStevens County Oil & Gas Company

Contractor

FIRST REPORT

C NW

1320 Ft. from N. Line

_____ Ft. from S. Line

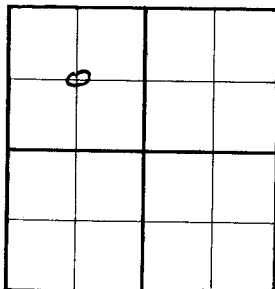
_____ Ft. from E. Line

1320 Ft. from W. Line

Gas

HUGOTON POOL

SECTION PLAT

Location X

Rig up _____

Drilling and Remarks:

RECORD

Cased _____ in., _____ ft.

Sand _____

Gas _____

Oil _____

Total Depth _____

PRODUCTION

1st 24 hrs. Nat. _____

1st 24 hrs. after shot _____

Gas _____ Cu. Ft.

Dry Hole _____

Abandoned _____

Date

JAN 12 1935

19

H. D. Hatfield Scout