


Section 34 Township 33 Range 32W

Well No. #1 J.E. Alexander

Company Columbian Fuel

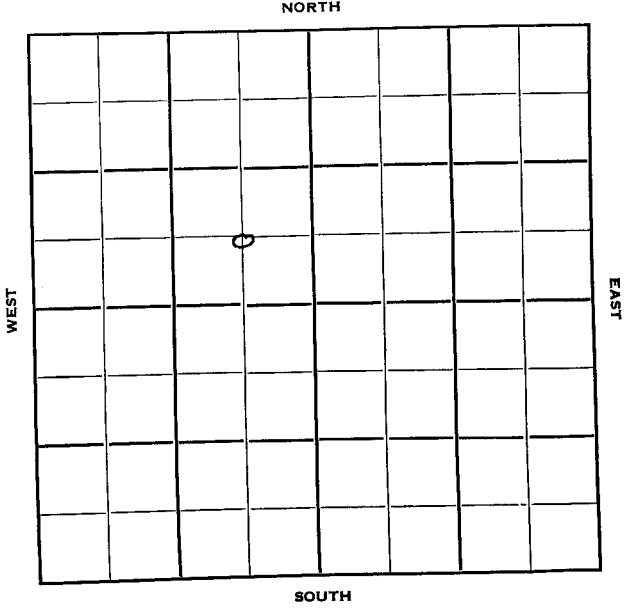

Seward

Sec. 34 Twp. 33 R. 32W

Well No. #1 J. E. Alexander Farm

Columbian Fuel Company

Contractor

Wildcat


2080 Ft. from N. Line

Ft. from S. Line

Ft. from E. Line

1980 Ft. from W. Line

NW 1/4 C SE NW

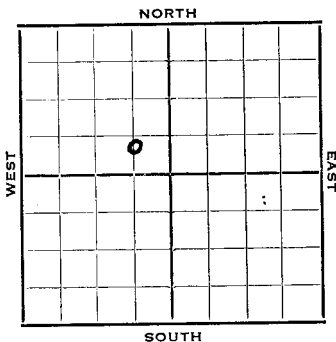

1952 Elev. 2673' REPORT

Deep Test

10/29	MIM		
LL/5	13" @ 639		
	Drlg. 2460'		
11/12	Schl 2570'	8" @ 2570	DST 2577-2602
	2 hrs, 30' VSGCM		
	DST 2927-57,	1 hr, 38' M	600#
	Drlg. 2960'		
11/20	DST 3416-62,	1 hr, 1410' SW	700#
	DST 3556-72',	1 hr, 960' SW	975#
	DST 3595-3625,	1 hr, 150' SW	930# 15"
11/27	NR		
12/4	"		
12/11	Ø5173		
12/18	Ø5550-82 29'	Ø5584-5636 48'	Ø 5638-60
12/25	"	"	"
1/1	NR		
1/8	NR		

OVER

#1 J. E. Alexander

1953
1/14

Spud 10-28-52
D&A TD 6000
13" @ 639
8" @ 2570
DST 2577-2602, opn 2 hrs., rec.
30' vsgcm 0#
DST 2927-57, opn 1 hr., rec.
38' mud 600#
DST 3416-62, opn 1 hr., rec.
1410' sw 700#
DST 3556-72, opn 1 hr., rec.
960' sw 975#
DST 3595-3625, opn 1 hr., rec.
150' sw 930#
DST 3980-4050, opn 1 hr., rec.
20' mud
DST 4305-36, opn 1 hr., rec.
30' swcm, 1095#
DST 4668-78, OPN 1 HR., REC.
330' mud sw 1500#
DST 4932-47, opn 1 hr., rec.
186' mud & sw 1230#
TD 6000
Schlumberger tops: Morrow 5610
Chester 5792'
Sample Tops: Hol 2460, Her.
2525, Kir. 2565, Win 2640, Ft.
Riley 2690, Lans 4310
D&A

ABANDONED

County **Seward** State **Kansas**

Sec. **34** (Blk. Twp.) **33** (Sur. Rge.) **32W** Map No.

Operator **Columbian Fuel**

Well No. **1** Farm **J. E. Alexander**

Elev. Location **C SE NW**



2080 Ft. From **N** Line **NW**

1980 Ft. From **W** Line **Quarter**

1st. Report **OCT 29 1952**

Completion

Remarks

Spudding Date

Drig. Data **Wildcat (deep test)**

M I M

Drlg. Data

SAMPLE TOPS

Hol. 2460 Her. 2525 Kir. 2565

Win. 2640 Ft. Riley 2690 Lays. 4310

- D & A
- Misc.
- Pierce Map
- France Map
- Tracings
- Land Wall Map
- Land Small Map
- Scout Cards

JAN 23 1953

[Handwritten initials]