


Seward

KANSAS

SECTION 34 TOWNSHIP 33S RANGE 33W

WELL NO. #1 Harnden

COMPANY Panhandle Eastern

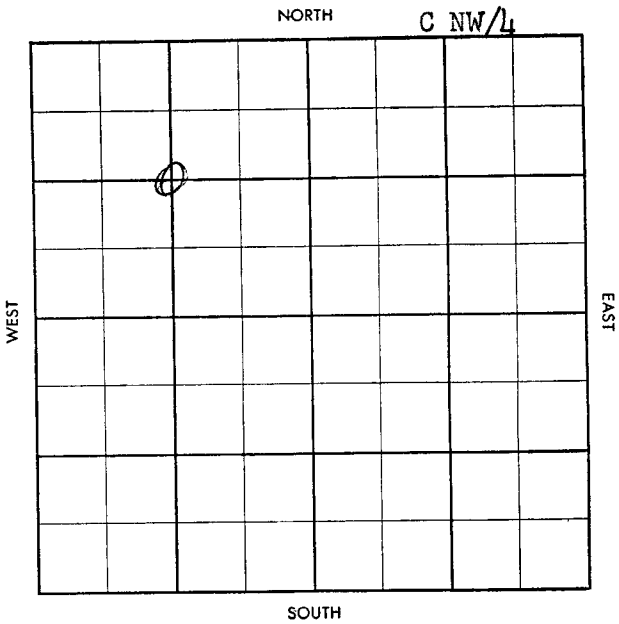

CORRECTION No. 10

S-513-B

County Seward Elev 28270 of 28300
 Sec. 34 Twp. 33 Rge. 33W
 Company Panhandle Eastern
 Farm Name Harnden No. 1-34

TOPS	DEPTH	LOG	DATUM
Ant. <u>Herr</u>		<u>2589</u>	
Tp. <u>Hold</u>		<u>2612</u>	
H. <u>win</u>		<u>2713</u>	
Tr.			
Dg.			
B.L.			
L.			
K.C.			
B.K.C.			
Co.			
C.			
M.			
M.			
K.			
Mz.			
Ma.			
V.			
S.			
S.			
A.			
R.			
Pf.			
G.			
T.D.	<u>2750</u>		

Loc. in Sec. C NW/4

Geol. _____

Contr. _____

Ward

Pool _____

Hugoton

SEP 3 '58

COMPLETE

Date Comm. 5-13-58

7" @ 621/215 4" @ 2749/100 MAY 28 '58 10/1
2622 -76 12/2711-19 44/
2594 -2605 2500 Act 261.732
meq + 60 g NPH JUN 3 '58 JUN 11 '58 JUN 18 '58
 JUN 25 '58 JUL 2 '58 JUL 9 '58 JUL 19 '58 JUL 23 '58
 JUL 30 '58 AUG 6 '58 AUG 13 '58 AUG 20 '58 AUG 27 '58
 SEP 3 '58 op F10 1.733 MCF pd

4

S-513-B

County Seward Elev. _____
 Sec. 34 Twp. 33 Rge. 33W
 Company Panhandle Eastern
 Farm Name Harnden No. 1

TOPS	DEPTH	LOG	DATUM
Anh.			
Tp.			
H.			
Tr.			
Dg.			
B.L.			
L.			
K.C.			
B.K.C.			
Ce.			
C.			
M.			
M.			
K.			
Mz.			
Mq.			
V.			
S.			
S.			
A.			
R.			
Pf.			
G.			
T.D.	<u>2750</u>		

Loc. in Sec.

C NW/4

Geol.

Contr.

Ward

Pool

Hugoton

Date Comm.

5-13-587" @ 621/2154" @ 2749/100