
Stevens

FORM 51 KANSAS

Section 34 Township 33 Range 38W

Well No. #1 Brecheisen

Company Republic Natural Gas

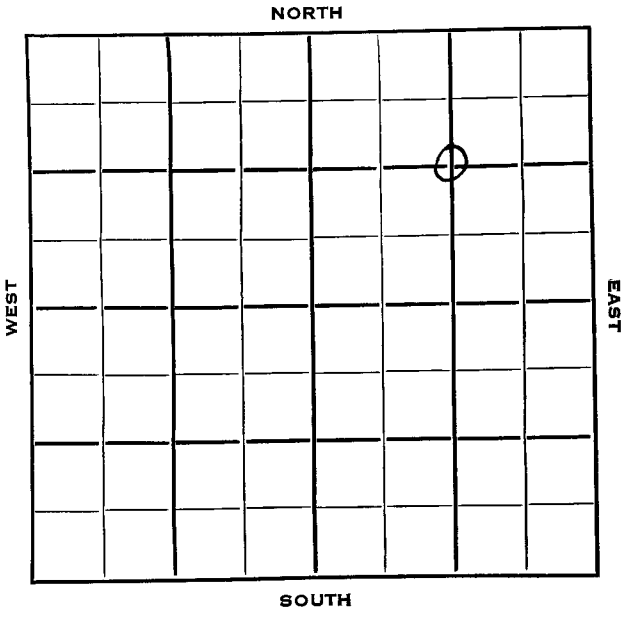

Stevens KANSAS

SEC.	TWP.	R.
34	33	38W ✓

WELL NO.

#1 Brecheisen FARM

COMPANY

Republic Natural Gas

CONTRACTOR


1320 Ft. from N. Line

Ft. from S. Line

1320 Ft. from E. Line

Ft. from W. Line

C NE/4

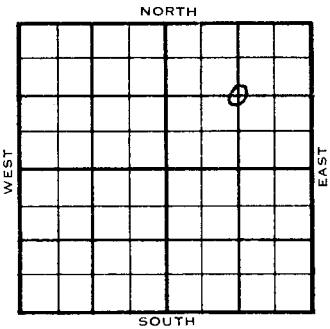

1953	ELEVATION 3190' REPORT
9/30	Location
11/18	10" @ 626'
12/9	RTD 2601' 5" @ 2590'
1954 3/3	Spud 11-11-53 Gas well TD 2771 10" @ 626 Hol. 2507 Her. 2555 Tri. 2589 Win. 2658 Ft. Riley 2707 TD 2601 5" @ 2590 DD 2771 15,000 A PB 1630 CO to 2742 Comp. 6,135,000 gas. COMPLETED

DX-78

FORM 275 FOR SALE BY KANSAS BLUE PRINT CO.


County Stevens State Kansas

Sec. 34 (Blk. Twp.) 33 (Sur. Rge.) 38W Map No.

Operator Republic Natural Gas

Well No. 1 Farm Brecheisen

Elev. Location C NE/4

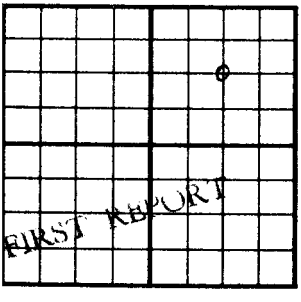

1320 Ft. From N Line NE

1320 Ft. From E Line Quarter

1st. Report SEP 30 1952

Completion

Remarks

Spudding Date

Drlg. Data

Location

FORM 275 FOR SALE BY KANSAS BLUE PRINT CO.


County Stevens State Kansas

Sec. 34 (Blk. Twp.) 33 (Sur. Rge.) 38W Map No.

Operator Republic Natural Gas

Well No. 1 Farm Brecheisen

Elev. 3190 Location C NE/4

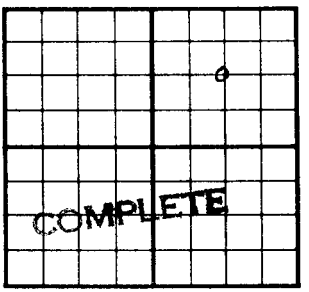

1320 Ft. From N Line W

1320 Ft. From E Line Quarter

1st. Report

Completion MAR

Remarks

Spudding Date 11-11-53

Drlg. Data Gas well TD 2771

10" @ 626 Hol. 2507 Mor. 2555

Yri. 2538 Win. 2653 Ft. Riley 2707

TD 2601 5" @ 2590 DD 2771 15000 A

PB 1638 CO to 2742

Comp. 6,125,000 gas

J. G. M...