

Morton KANSAS

35

33

41W

SECTION TOWNSHIP RANGE


#1 Eagley

WELL NO.

P.E.P.L.

COMPANY

NORTH

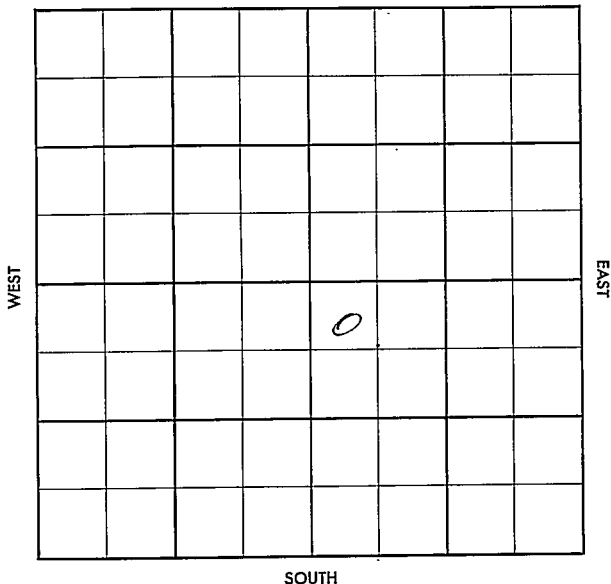

Morton

KANSAS

SEC.

35

TWP.

33

R.

41W

WELL NO.

#1 Eagley

FARM

COMPANY

P.E.P.L.

CONTRACTOR

Garvey Tools
Hugoton

_____ FT. FROM N. LINE


_____ FT. FROM S. LINE

_____ FT. FROM E. LINE

430

_____ FT. FROM W. LINE

NW NW SE

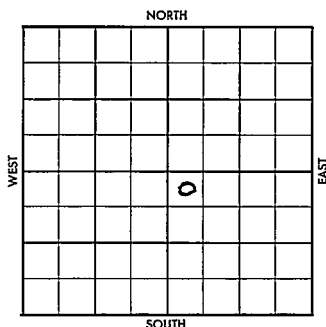

1956

ELEVATION

REPORT

9-12

Comm 9-4-56
 7" @ 447 w 175
 4" @ 2342 w/350
 WOCT

DEC 5 '56 DEC 12 '56 ST. Deliv. +st.

482 MCFG

35-33-41

mw mw re

FORM 513 SUNRAY

Co.

County MORTON Elev. 41W
 Sec. 35 Twp. 33 Rgs. 41W
 Company P. E. P. L.
 FarmName Eagley No. 1-35

TOPS	DEPTH	LOG	DATE	Loc. in Sec.
Ans				NE N. SE
Ep	<u>WEL</u>	<u>2-20-2</u>		
H	<u>WEL</u>	<u>2-21-2</u>		430 wt
Tr				
Dg				
Bl				
L				
K.C.				Geol.
B.K.C.				Contr
Ce				Garvey Tools
C				
M				Pool
M				Hugoton
K				
Mz				
Ma				
V				
S				
S				
A				
R				
Pe				
G				
TD	<u>2360</u>			

COMPLETE
 DEC 13 '55

No.

No.

No.

No.

No.

Date Comm. 9-4-56

7" @ 449 w/175, 4" @ 2342 w/350, WOOT SEP 19 '56
 CO 2338 GRNL 35/2267-74
 35/2281-88 55 G 11 ga 926
 MCF 13 ga 1.22 MCF PB?
 24/2201-05 24/2209-13
 40/2224-31 42/2235-42
 12/2249-52 2 Pgd. LW Pgs.
 12/26 '56 10 ga 1.940 MCF 159 to
 2-774 OCT 3 '55 OCT 10 '55 OCT 17 '55 OCT 24 '55
 OCT 31 '55 NOV 7 '55 NOV 13 '55 NOV 21 '55 NOV 28 '55

