


KANSAS

FORM 51 25M 3-49 PETROL

Section 35 Township 33 Range 40 W

Well No. 1-35 Stout

Company Penhandle Eastern

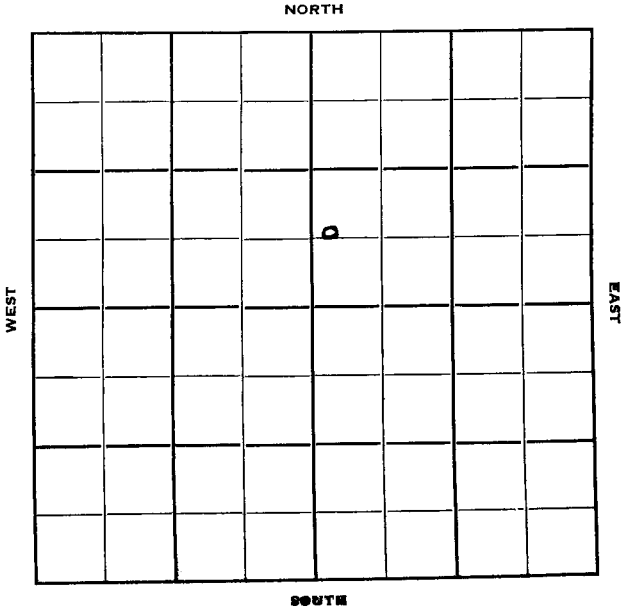

KANSAS

Morton

Sec. 35 Twp. 33 R. 40W

Well No. #1-35 Stout Farm

Panhandle Eastern Company

Contractor

Iugoton


1960 Ft. from N. Line

Ft. from S. Line

2500 Ft. from E. Line

Ft. from W. Line

SW NE

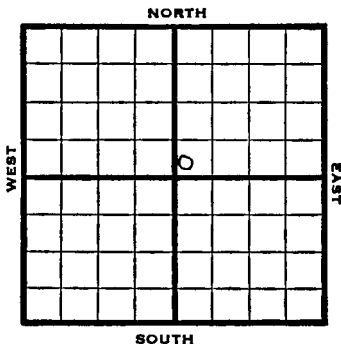

Gas Well

1050

Elev 3298

REPORT

5/10 Location

10/11 10" @ 526

7" @ 2421

TD 2630

3000 A

Her 2425

Krider 2450

Win 2520

Ft. Riley 2587

Comp 935,000 gas Del

Completed

COMPLETED

Kansas

Map No. _____ Sec. 35 Twp. 33 R. 40NWell No. 1-35 Stout

_____ Panhandle Eastern _____ Company

_____ Contractor

SW 1/4

SECTION PLAT

1960 Ft. from N. Line

_____ Ft. from S. Line

2500 Ft. from E. Line

_____ Ft. from W. Line

		2	
FIRST REPORT			

Horton

Location X

Rig up _____

Drilling and Remarks:

RECORD

Cased _____ in., _____ ft.

Sand _____

Gas _____

Oil _____

Total Depth _____

PRODUCTION

1st 24 hrs. Nat. _____

1st 24 hrs. after shot _____

Gas _____ Cu. Ft.

Dry Hole _____

Abandoned _____

Date

MAY 10 1950 J. E. TYRA Scout

