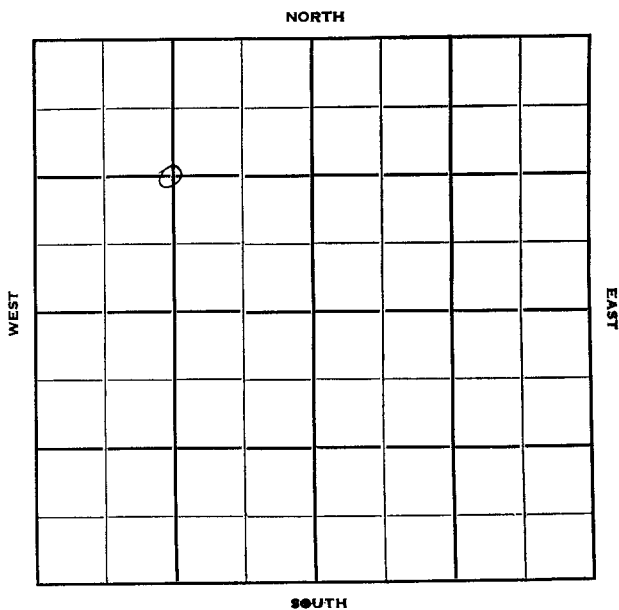


Section 35 Township 33 Range 34WWell No. #1 C. E. CookCompany Cabot Carbon

Seward

1618500 ✓

Sec. 35 Twp. 33 R. 34W

Well No. #1 C. E. Cook Farm

Cabot Carbon Company

Hugoton Pool Contractor


1320' Ft. from N. Line

_____ Ft. from S. Line

_____ Ft. from E. Line

1320' Ft. from W. Line

C NW

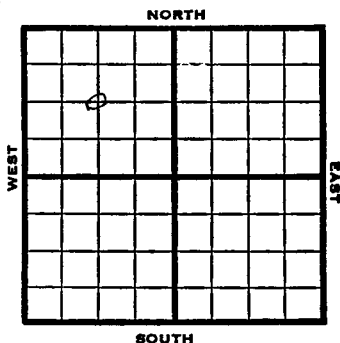

1950 Elev. 2910' REPORT

2/20 Spud 12-7-50
10" @ 675'
TD 2665'
7" @ 2648'

1951
3/14 Spud 12-7-50
Gas well TD 2720'
10" @ 675, 7" @ 2648, TD 2720
Her. 2645, Krider 2665,
20/ 2710-15, 30/ 2685-90,
21/ 2710-13 13,000 A
Comp. 9,472,000 gas 422#
COMPLETED


County Seward State Kansas

Sec. 35 (Blk.) 33 (Sur.) 34W Map No.

Operator Cabot Carbon

Well No. 1 Farm C. E. Cook

Elev. Location C NW

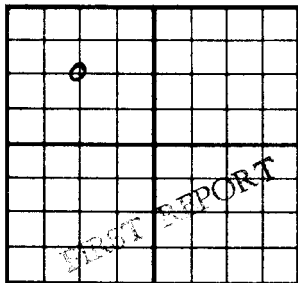

1320 Ft. From N Line NW

1320 Ft. From W Line Quarter

1st. Report DEC 20 1950

Completion

Remarks

Spudding Date 12-7-50

Drlg. Data Hugoton Pool


10" @ 675 TD 2665 7" @ 2648

County Seward State Kansas
 Sec. 35 (Blk. 33 (Sur. 34W Map No. 33)
 (Twp.) (Rge.)

Operator Cabot Carbon

Well No. 1 Farm C. E. Cook

Lev. 2910 Location C NW/4

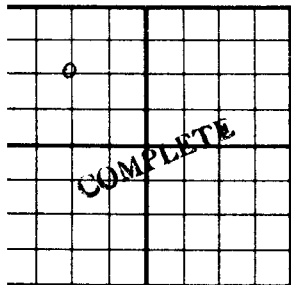

1320 Ft. From N Line NW

1320 Ft. From W Line Quarter

1st. Report

Completion MAR 14 1951

Remarks Hugoten Pool

Spudding Date 12-7-50

Orig. Data Gas well TD 2720

10" @ 675 7" @ 2648 TD 2720

Her. 2645 Krider 2665 20/ 2710-15

30/ 2685-90 21/ 2710-13 13000 A

Comp. 9,472,000 gas 422#

J. E. TYRA