


Section 36 Township 33 **KANSAS** Range 39-W

Well Number 2 Halbock (*Hallock*)

Company McKnabb O&G

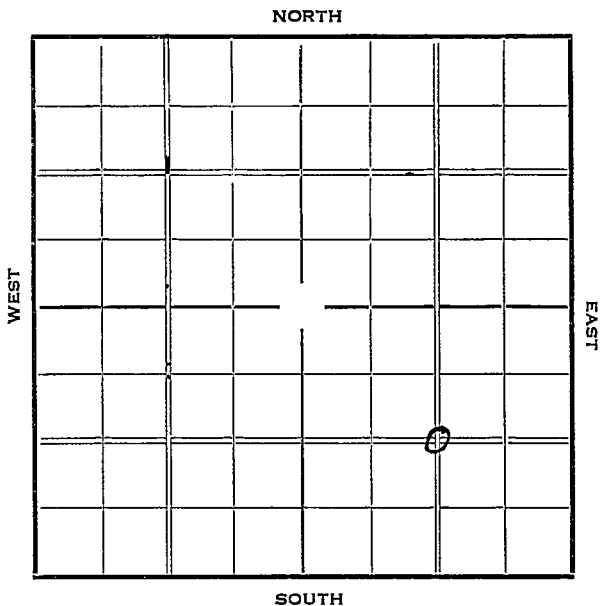

Sec. 36 Twp. 33 R. 39-W


Well No. #2 Hallock Farm  
McKnaff O & G Company

\_\_\_\_\_ Ft. from N. Line

1320 Ft. from S. Line

1320 Ft. from E. Line

\_\_\_\_\_ Ft. from W. Line

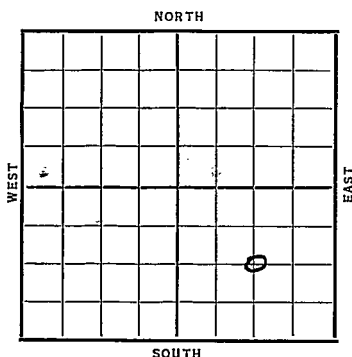

Date	REPORT
1936	
11/25	Rigging up. This is on an abandoned location.
12/3	No Report.
12/10	Rigging up.
12/17	12" @ 553'. 1750' fishing.
12/24	Skid Rig.
12/29	" "
1937	
1/7	Skid rig 200' east.
1/14	No report.
1/21	" "
1/28	Drlg. 1365'.
2/4	T. D. <del>2165</del> fishing. 1365
2/11	Shut Down 1490'!
2/18	" " "
2/26	No Report
3/4	8" @ 1420' Drlg. 2133'.
3/11	5" @ 2531' Pull big pipe.
3/18	" " " " "
3/25	Drlg. 2612'.
	<b>OVER</b>

1937

3/31 Sand 2531'.

T.D. 2660'.

5 M gas.

**COMPLETED**

# KANSAS




Contractor


## SECTION PLAT

\_\_\_\_\_ Ft. from N. Line

1320 Ft. from S. Line

1320 Ft. from E. Line

\_\_\_\_\_ Ft. from W. Line

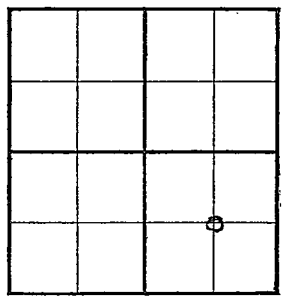

## FIRST REPORT

Location \_\_\_\_\_

Rig up \_\_\_\_\_

Drilling and Remarks:

*Rigging up  
This is on an  
abandoned  
Location.*

## RECORD

Cased \_\_\_\_\_ in., \_\_\_\_\_ ft.

Sand \_\_\_\_\_

~~Gas~~ \_\_\_\_\_

Oil \_\_\_\_\_

Total Depth \_\_\_\_\_

## PRODUCTION

1st 24 hrs. Nat. \_\_\_\_\_

1st 24 hrs. after shot \_\_\_\_\_

Gas \_\_\_\_\_ Cu. Ft.

Dry Hole \_\_\_\_\_

Abandoned \_\_\_\_\_

Date

NOV 25 1936 19 \_\_\_\_\_

S. J. LEWIS Scout

**KANSAS** *Stevens*


Map No. *N 19* Sec. *36* Twp. *33* R. *39W*

Well No. *2 Hallock*

*McKnatt Oil & G.* Company

Contractor

**SECTION PLAT**

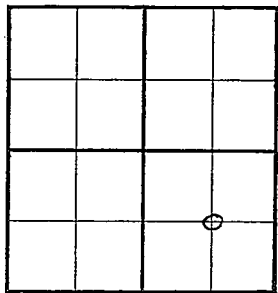

\_\_\_\_\_ Ft. from N. Line

*1320* Ft. from S. Line

*1320* Ft. from E. Line

\_\_\_\_\_ Ft. from W. Line

**COMPLETED**

Location \_\_\_\_\_

Rig up \_\_\_\_\_

Drilling and Remarks: *1*

*Sand 2531*

*5 M Gas.*

**RECORD**

Cased \_\_\_\_\_ in., \_\_\_\_\_ ft.

Sand \_\_\_\_\_

Gas \_\_\_\_\_

Oil \_\_\_\_\_

Total Depth *2660*

**PRODUCTION**

1st 24 hrs. Nat. \_\_\_\_\_

1st 24 hrs. after shot \_\_\_\_\_

Gas \_\_\_\_\_ Cu. Ft.

Dry Hole \_\_\_\_\_

Abandoned \_\_\_\_\_

Date

MAR 31 1937 19

S. J. LEWIS Scout