

KANSAS.

Stevens county


FORM 51 5M 6-46 PETROL

Section 36 Township 33 Range 39-W

Well No. #1, Berryman

Company Panhandle Eastern

NORTH

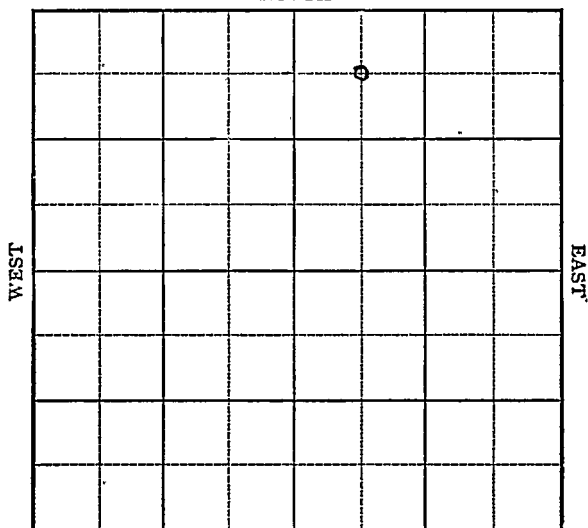


SOUTH

KANSAS

Sec. 36 Twp. 33-S R. 39-WWell No. #1 Berryman FarmPanhandle Eastern

Company

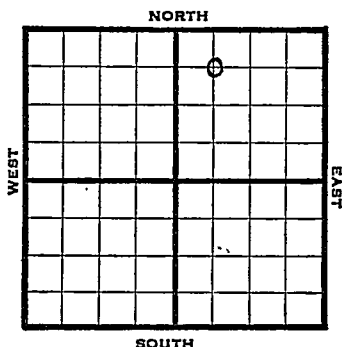660' Ft. from N. Line Ft. from S. Line Ft. from E. Line660' Ft. from W. Line
C NW NE

1946

Elev. 3228' REPORT

9/5	Location		
9/10	10" @ 680 WOC		
9/18	TD2526		
	7" @ 2520'		
	RUST		
9/24	TD 2715'		
	223' of 5" Perf liner @ 2715'		
10/1	"	"	"
10/8	"	"	"
10/15	"	"	"
10/22	"	"	"
10/29	"	"	"
11/6	"	"	"
11/12	"	"	"
11/20	"	"	"
11/27	"	"	"
12/3	"	"	"
12/10	"	"	"
12/17	"	"	"
1947			
1/2	7" @ 2520'		
	223' of 5" Perf Liner @ 2715'		
	TD 2715'		
	13500 Acid		
	32, 913,000 Gas		
	340# RPR		

COMPLETED

KANSAS Kansas Pool Name Hugoton
 Map No. _____ Sec. 36 Twp. 33 R. 39W
 Well No. 1 Berryman

Panhandle Eastern Company

FIRST REPORT Contractor

C NW NE


SECTION PLAT

660 Ft. from N. Line

_____ Ft. from S. Line

_____ Ft. from E. Line

660 Ft. from W. Line

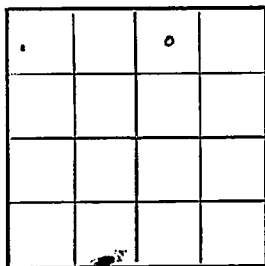

Stevens County

Location X

Rig up _____

Drilling and Remarks:

RECORD

Cased _____ in, _____ ft.

Sand _____

Gas _____

Oil _____

Total Depth _____

PRODUCTION

1st 24 hrs. Nat. _____

1st 24 hrs. after shot _____

Gas _____ Cu. Ft.

Dry Hole _____

Abandoned _____

Date

SEP 5 1946 19

S. J. LEWIS

Scout

Map No. _____ Sec. 36 Twp. 33 R. 39W

Well No. 1 Berryman

Panhandle Eastern

Company

COMPLETED

Contractor

C NW NE

E13228

SECTION PLAT

660 Ft. from N. Line

_____ Ft. from S. Line

_____ Ft. from E. Line

660 Ft. from W. Line

		o	

Stevens County

Location _____

Rig up _____

Drilling and Remarks:

7" @ 2520'
228' of 5" Pay line
@ 2715'

13500 cu ft

32,913,000 cu

240 # R/P

RECORD

Cased _____ in., _____ ft.

Sand _____

Gas _____

Oil _____

Total Depth 2715'

PRODUCTION

1st 24 hrs. Nat. _____

1st 24 hrs. after shot _____

Gas _____ Cu. Ft.

Dry Hole _____

Abandoned _____

Date

JAN 2 1947

19

S. J. LEWIS

Scout