


Stevens  
Form 51-5M-2-29-34703

Map No. KANSAS Sec. 36 Twp. 33 R. 39<sup>W</sup>

Well No. Mc Nabbs O & B Farm  
Company

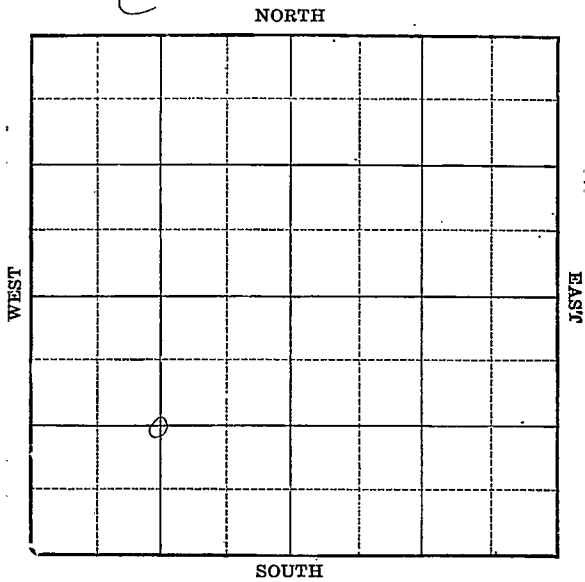

Location \_\_\_\_\_  
Drilling Remarks \_\_\_\_\_  
\_\_\_\_\_  
\_\_\_\_\_  
Rig Up \_\_\_\_\_  
Drilling Remarks \_\_\_\_\_  
\_\_\_\_\_  
\_\_\_\_\_  
**RECORD**

Cased \_\_\_\_\_ in. \_\_\_\_\_ ft.  
Sand \_\_\_\_\_  
Gas \_\_\_\_\_  
Oil \_\_\_\_\_  
Total Depth \_\_\_\_\_

**PRODUCTION**

1st 24 hrs. Nat. \_\_\_\_\_  
1st 24 hrs. after shot \_\_\_\_\_  
Gas \_\_\_\_\_ cu. ft. \_\_\_\_\_  
Dry Hole \_\_\_\_\_  
Abandoned \_\_\_\_\_

Map No. KANSAS Sec. 36 Twp. 33 R. 39<sup>w</sup>

Well No. 1 - Hallock Farm  
Mc Nabbs Oil & Gas Company


\_\_\_\_\_ Ft. from N. Line

1320 Ft. from S. Line

\_\_\_\_\_ Ft. from E. Line

1320 Ft. from W. Line

1931

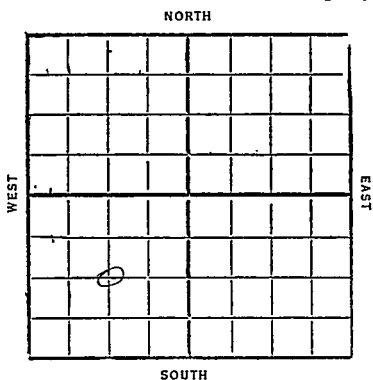

Date

REPORT

| Date  | REPORT           |
|-------|------------------|
| 8/26  | Spec             |
| 9/12  | Core             |
| 9/19  | Drill 6' 78"     |
| 9/16  | " 2275'          |
| 9/23  | SD 2540'         |
| 9/30  | 6" - 2549        |
|       | Drill 2552'      |
| 10/7  | SD 2552'         |
| 10/14 | Land 2620 - 2786 |
|       | TD 2786          |
|       | 10 ft gas        |
|       | Comp.            |

Stevens

Map No. KANSAS Sec. 36 Twp. 33 R. 39 <sup>W</sup>Well No. 1 HallockMcNabb Oil & Gas Company

Contractor

## FIRST REPORTS

## SECTION PLAT

.....Ft. from N. Line

1320 Ft. from S. Line

.....Ft. from E. Line

1320 Ft. from W. Line

|  |  |  |  |
|--|--|--|--|
|  |  |  |  |
|  |  |  |  |
|  |  |  |  |
|  |  |  |  |
|  |  |  |  |

Location.....✓

Rig up.....

Drilling and Remarks:

## RECORD

Cased.....in., .....ft.

Sand.....

Gas.....

Oil.....

Total Depth.....

## PRODUCTION

1st 24 hrs. Nat.....

1st 24 hrs. after shot.....

Gas.....Cu. Ft.

Dry Hole.....

Abandoned.....

Date

AUG 26 1931

CHAS. L. SHERWOOD

192

Scout

Map No. KANSAS Sec. 36 Twp. 33 R. 29<sup>W</sup>

Well No. 1 Hallock

Mc Hale Oil & Gas Company

Contractor

## COMPLETED


\_\_\_\_\_ Ft. from N. Line

1320 Ft. from S. Line

\_\_\_\_\_ Ft. from E. Line

1320 Ft. from W. Line

## SECTION PLAT

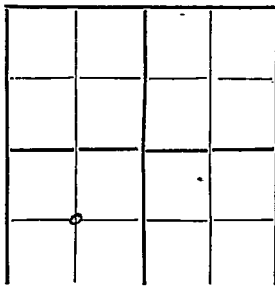

Location \_\_\_\_\_

Rig up \_\_\_\_\_

Drilling and Remarks:

## RECORD

Cased \_\_\_\_\_ in., \_\_\_\_\_ ft.

Sand 2620-2786

Gas \_\_\_\_\_

Oil \_\_\_\_\_

Total Depth 2786

## PRODUCTION

1st 24 hrs. Nat. \_\_\_\_\_

1st 24 hrs. after shot. \_\_\_\_\_

Gas 10 M Cu. Ft.

Dry Hole \_\_\_\_\_

Abandoned \_\_\_\_\_

Date

OCT 14 1931

192 CHAS. L. SHERWOOD  
Scout

5/800 L266  
20/800/208

no further  
no

|                  |     |
|------------------|-----|
| Returned         | JEP |
| 1. - 2/2         |     |
| France Map       |     |
| Scarborough Map  |     |
| Moody Map        |     |
| Scarborough Book |     |
| Moody Plot       | *   |