

KANSAS


Form 51-5M-4-36-Palace

Stevens

Section 36 Township 33 Range 39-W

Well Number #2-Hallock

Company Southwest Kansas O & Gas

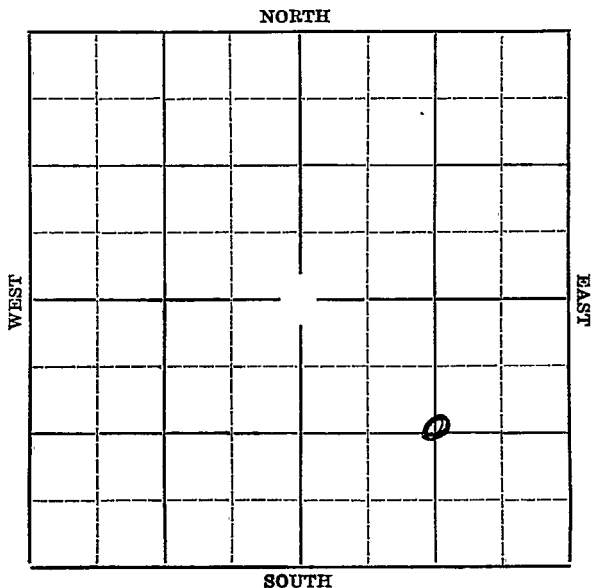

Map No. KANSAS Sec. 36 Twp. 33 R. 39W

Well No. #2 Hallock Farm


Southwest Kansas O & Gas Company

 Ft. from N. Line

1320' Ft. from S. Line

1320' Ft. from E. Line

 Ft. from W. Line

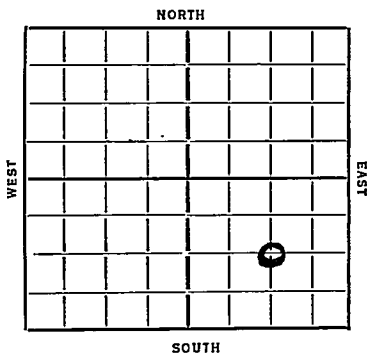

Date 1936

REPORT

8/12 Location

8/20 --

8/27 -- 9/3 -- 9/10 -- 9/18 -- 9/24 -- 10/1 --

10/8 Rig on ground.

10/15 -- 10/22 -- 10/29 -- 11/6 --


11/10 Location Abandoned

ABANDONED

Map No. No Maps Sec. 36 Twp. 23 R. 39WWell No. 2 Ho. LockSouthwest Kansas Oil & Gas Company

Contractor

SECTION PLAT

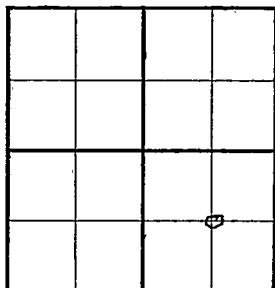

_____ Ft. from N. Line

1320 Ft. from S. Line1320 Ft. from E. Line

_____ Ft. from W. Line

1320Location ✓

Rig up _____

Drilling and Remarks:

RECORD

Cased _____ in., _____ ft.

Sand _____

Gas _____

Oil _____

Total Depth _____

PRODUCTION

1st 24 hrs. Nat. _____

1st 24 hrs. after shot _____

Gas _____ Cu. Ft.

Dry Hole _____

Abandoned _____

Date

Aug 12 1936

19


S. J. LEWIS Scout

KANSAS

Map No. No 142ps Sec. 36 Twp. 33 R. 39WWell No. 2 HallackSouthwest Kansas Oil & Gas Company

Contractor

SECTION PLAT

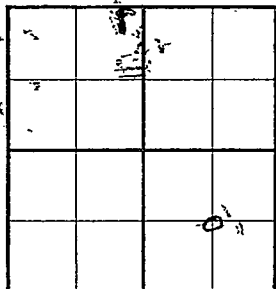

_____ Ft. from N. Line

1320 Ft. from S. Line1820 Ft. from E. Line

_____ Ft. from W. Line

ABANDONED

RECORD

Location ✓

Cased _____ in., _____ ft.

Rig up _____

Sand _____

Drilling and Remarks:

Gas _____

Oil _____

Total Depth _____

PRODUCTION

1st 24 hrs. Nat. _____

1st 24 hrs. after shot _____

Gas _____ Cu. Ft.

Dry Hole _____

Abandoned _____

Date

NOV 10 1936 19

S. J. LEWIS Scout