KANSAS Stevens


FORM 51 5M PETROL

Section 36 Township 33 Range 37W

Well No. 2 Carpenter

Company Republic Nat. Gas

11

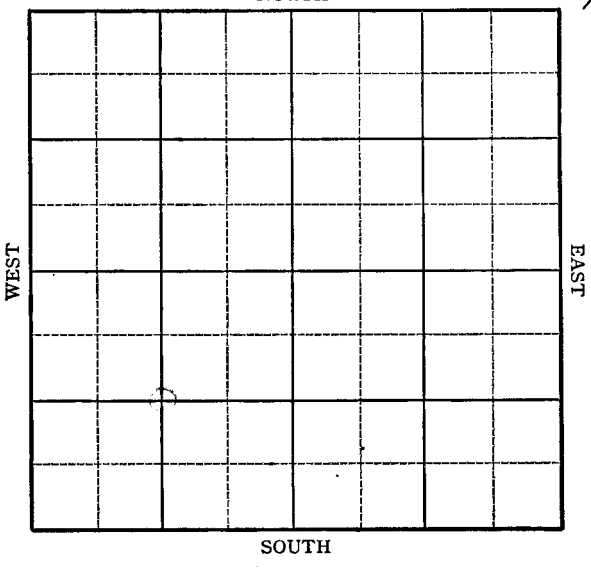

FORM 252 A
M 3-45 PETROL

KANSAS Stevens

Sec. 36 Twp. 33 R. 37W

Well No. 2 Carpenter Farm

Republic Nat. Gas Company

Hugoton


_____ Ft. from N. Line

1320 Ft. from S. Line

_____ Ft. from E. Line

1320 Ft. from W. Line

C SW Elev. 3095

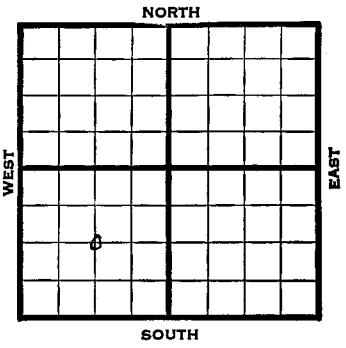

1945	REPORT
6/20	Location
6/28	"
/3	RUR
/11	16" @ 635' WOC
7/19	7" @ 2589
	TD 2600 RUST [illegible] 2610
7/26	" " "
8/1	" " "
8/8	" " "
8/15	" " "
8/22	" " "
8/29	Drlg. 2715 1 M Gas
9/5	TD 2850
	271' of 5" perf. liner @ 2850
9/12	" " " " "
9/19	" " " " "
9/26	" " " " "
10/3	" " " " "
10/10	" " " " "
10/17	" " " " "
10/24	" " " " "
10/31	7" @ 2589
	5" liner @ 2850
	TD 2850
	12,500 acid
	23,153,000 Gas
	385# R Pr.

COMPLETED

FORM 56 200 BKS, 1-44 PETROL

KANSAS Kansas Pool Name Hugoton

Map No. [illegible] Sec. 36 Twp. 33 R. 37W

Well No. 2 Carpenter

Republic Nat. Gas Company


COMPLETED

Contractor

C SW

E1.3095

SECTION PLAT

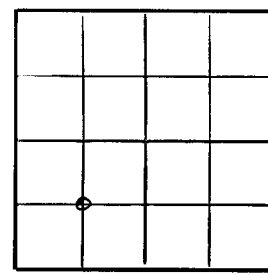

Ft. from N. Line

1320 Ft. from S. Line

Ft. from E. Line

1320 Ft. from W. Line

Stevens County

Location

Rig up

Drilling and Remarks:

7" @ 2589

5" liner @ 2853

12500 acid

23,153,000 Gas

385# RP

RECORD

Cased in., ft.

Sand

Gas

Oil

Total Depth 2853

PRODUCTION

1st 24 hrs. Nat.

1st 24 hrs. after shot

Gas Cu. Ft.

Dry Hole

Abandoned

Date

OCT 31 1945 19 S. J. LEWIS Scout

FORM 56 200 BKS, 1-44 PETROL

Kansas Pool Name Hugoton

Map No. 210 Map Sec. 36 Twp. 33 R. 37W


Well No. 2 Carpenter

Republic Nat.Gas. Company

FIRST REPORT Contractor

C SW

SECTION PLAT

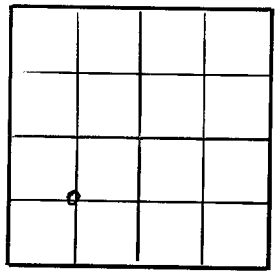

____ Ft. from N. Line

1320 Ft. from S. Line

____ Ft. from E. Line

1320 Ft. from W. Line

Stevens County

Location X

Rig up

Drilling and Remarks:

RECORD

Cased ____ in., ____ ft.

Sand

Gas

Oil

Total Depth

PRODUCTION

1st 24 hrs. Nat.

1st 24 hrs. after shot

Gas ____ Cu. Ft.

Dry Hole

Abandoned

Date

JUN 20 1945 19

S. J. LEWIS Scout