


Company Panhandle Eastern

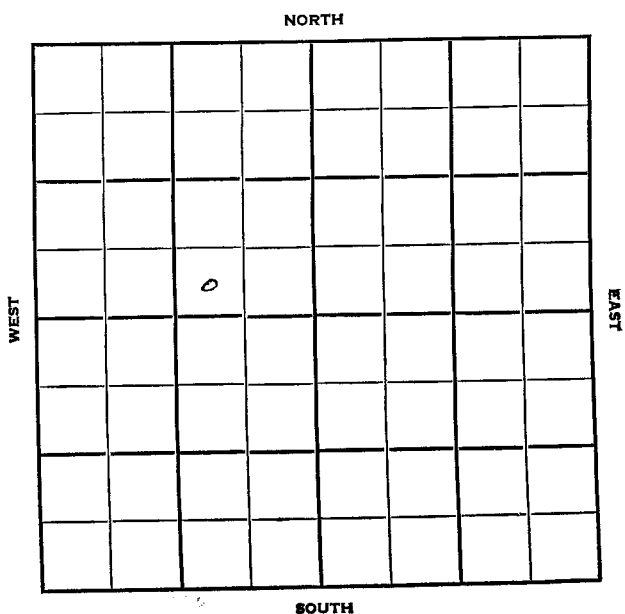

Seward KANSAS

SEC.	TWP.	R.
36	33	33W

WELL NO. _____

1 Heard _____ FARM

COMPANY _____

CONTRACTOR _____

Panhandle Eastern _____


Burris _____

2465 _____ Ft. from N. Line

_____ Ft. from S. Line

_____ Ft. from E. Line

1500 _____ Ft. from W. Line

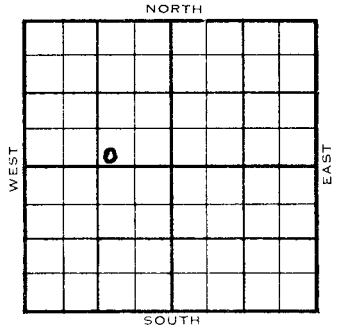

SW SE NW

1955	ELEVATION	REPORT
------	-----------	--------

4/6 _____

RUR _____

County Seward State Kansas

Sec. **36** (Blk. **33** (Sur. **3 3W** Map No.

Operator **Panhandle Eastern**

Well No. 1 Farm Heard

Elev.	Location	SW	SE	NW
-------	----------	----	----	----

2465 Ft. From N Line NW

1500 Ft. From **W** Line Quarter

1st. Report APR 6 1957

Completion

Remarks

Burris - Contr.

Spudding Date _____

Drig. Data Hugoton Pool

R U R

