

WELL COMPLETION REPORT AND DRILLER'S LOG

API No. 15 — 189 — 20,441
County Number

Operator

Anadarko Production Company

Address
P. O. Box 351, Liberal, Kansas 67901

Well No. 2 Lease Name DUNNE-HOFFMAN "C"

Footage Location
1250 feet from (N) (S) line 1400 feet from (E) (W) line

Principal Contractor Geologist
Lohmann-Johnson Drlg Co. Joe Blair


Spud Date Date Completed Total Depth P.B.T.D.
3/5/79 11/26/79 6200' 6126'

Directional Deviation Oil and/or Gas Purchaser
1/4 deg @ 6200' None

S. 23 T. 33S R. 38 W
Loc. 1250' FNL & 1400' FEL

County Stevens

640 Acres
N

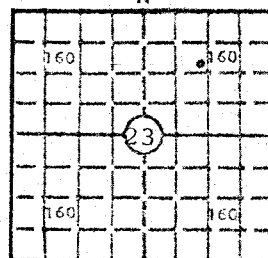

Elev.: Gr. 3148'
DF 3157' KB 3158'

CASING RECORD

Report of all strings set — surface, intermediate, production, etc.

Purpose of string	Size hole drilled	Size casing set (in O.D.)	Weight lbs/ft.	Setting depth	Type cement	Sacks	Type and percent additives
Surface	12-1/4"	8-5/8"	24#	1707	Pozmix Common	600 200	4% gel 2% CaCl 3% CaCl
Production	7-7/8"	4-1/2"	10.5#	6198	Pozmix First Stage	160	SS .05% CFR-2
DV Tool				3135	2nd Lite-wate stage Pozmix	500 150	4% gel SS .05% CFR-2

LINER RECORD

PERFORATION RECORD

Top, ft.	Bottom, ft.	Sacks cement	Shots per ft.	Size & type	Depth interval
TUBING RECORD			2	3-1/8" csg gun	6088-6100'
Size	Setting depth	Packer set at			

ACID, FRACTURE, SHOT, CEMENT SQUEEZE RECORD

Amount and kind of material used	Depth interval treated
1200 gal 7.5% HCS	6088-6100'

INITIAL PRODUCTION

Date of first production		Producing method (flowing, pumping, gas lift, etc.)			
Dry Hole		Swabbing			
RATE OF PRODUCTION PER 24 HOURS	Oil	Gas	Water	Gas-oil ratio	
	---	---	27	---	
	bbls.	MCF	bbls.	CFPB	
Disposition of gas (vented, used on lease or sold)			Producing interval(s)		
Dry Hole			6088-6100'		

INSTRUCTIONS: As provided in KCC Rule 82-2-125, within 90 days after completion of a well, one completed copy of this Drillers Log shall be transmitted to the State Geological Survey of Kansas, 4150 Monroe Street, Wichita, Kansas 67209. Copies of this form are available from the Conservation Division, State Corporation Commission, 245 No. Water, Wichita, Kansas 67202. Phone AC 316-522-2206. If confidential custody is desired, please note Rule 82-2-125. Drillers Logs will be on open file in the Oil and Gas Division, State Geological Survey of Kansas, Lawrence, Kansas 66044.

Operator Anadarko Production Company		DESIGNATE TYPE OF COMP.: OIL, GAS, DRY HOLE, SWDW, ETC.:
Well No. 2	Lease Name DUNNE-HOFFMAN "C"	DRY HOLE
S 23 T 33S R 38E W		

WELL LOG


Show all important zones of porosity and contents thereof; cased intervals, and all drill-stem tests, including depth interval tested, cushion used, time tool open, flowing and shut-in pressures, and recoveries.

SHOW GEOLOGICAL MARKERS, LOGS RUN,
OR OTHER DESCRIPTIVE INFORMATION.

FORMATION DESCRIPTION, CONTENTS, ETC.	TOP	BOTTOM	NAME	DEPTH
Sand	0'	540'	LOGS: Schlumberger Dual Induction-SFL Compensated Neutron- Formation Density	
Redbed	540'	825'		
Sand, Redbed	825'	1180'		
Sand, Shale	1180'	1707'		
Shale	1707'	2270'		
Lime, Shale	2270'	2545'		
Shale	2545'	2780'		
Lime, Shale	2780'	6170'		
Lime	6170'	6205'		

USE ADDITIONAL SHEETS, IF NECESSARY TO COMPLETE WELL RECORD.

Date Received

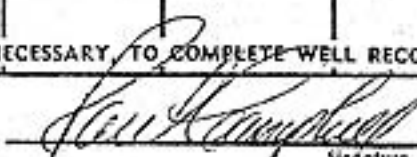

Signature

Paul Campbell, Division Production Manager

Title

December 5, 1979

Date