


Sumner

KANSAS

SECTION 2 TOWNSHIP 33 RANGE 4W

WELL NO. #1 Stevens

COMPANY Adair & Brann

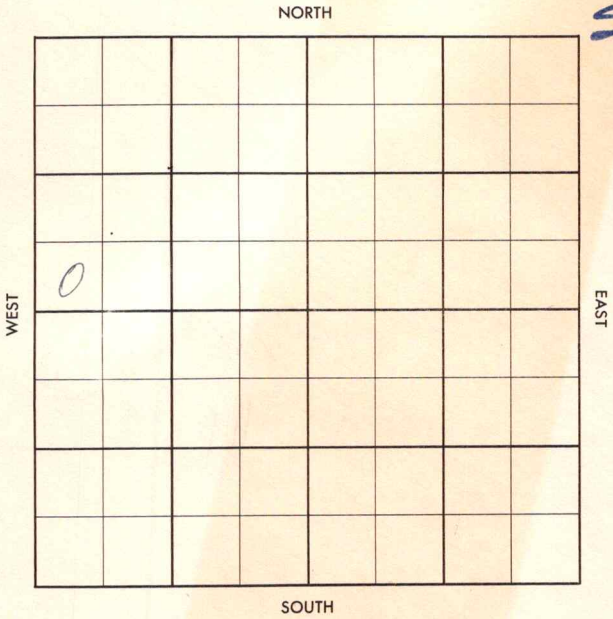


# WILDCAT

FORM 513 SUNRAY

County Summer Elev. \_\_\_\_\_  
Sec. 2 Twp. 33 Rge. 4W  
Company Adair & Brann  
FarmName Stevens No. 1

TOPS	DEPTH	LOG	DATUM
Anh.			
Tr.			
H.			
Tr.			
Dg.			
Bl.			
L.			
K.C.			
B.K.C.			
Ce.			
C.			
M.			
M.			
K.			
Mz.			
Me.			
V.			
S.			
S.			
A.			
R.			
PC.			
G.			
T.D.			

Loc. in Sec. \_\_\_\_\_  
SW SW NW  
Geol. \_\_\_\_\_  
Contr. \_\_\_\_\_  
Graham-Michaelis  
Pool  
Wildcat

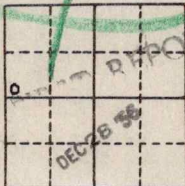

Date Comm. 12-20-56 Amerada (DHM)  
no surf, Drlg. 1620

~~28~~

Co.

Use.

No.

Sec.

T.

R.

County Sumner Elev. 1259 DF  
 Sec. 2 Twp. 33 Rge. 4W  
 Company Adair & Brann  
 Farm Name Stevens No. 1

TOPS	DEPTH	LOG	DATUM	Loc. in Sec.
Anh.				SW SW NW
TP.				
H. <u>stall</u>	<u>2077</u>			
Tr.				
Dg.				
Bl.				
L.				Geol.
K.C.	<u>3398</u>			Contr.
B.K.C.	<u>3668</u>			<u>Graham-Michaelis</u>
Ce.				
C.				Pool
M.	<u>4073</u>			<u>wildcat</u>
M.				<b>ABANDONED</b>
K.	<u>4392</u>			
Mz.				
Mo. <u>chata</u>	<u>4450</u>			
V.				
S.	<u>4476</u>			
S.				
A.				
R.				
PE.				
G.				
T.D.	<u>4481</u>			16 '57

Date Comm. 12-20-56 Amerada (DHM)  
 no surf, Drlg. 1620 "4 2 57" # 3399  
 JAN 9 1957 # 4266 JUN 18 1957 DST  
4474-81 1hw 750' SW FP 60-450  
BHP 1790  
D&A.

Co.

Use

No.

Sec.

T.

R.