FORM 51 25M 8-50 WESTERN Sumner


KANSAS

Section 7 Township 33 Range 4W

Well No. #1 Wansch

Company Stickle Drlg. & Harwood Oil

8

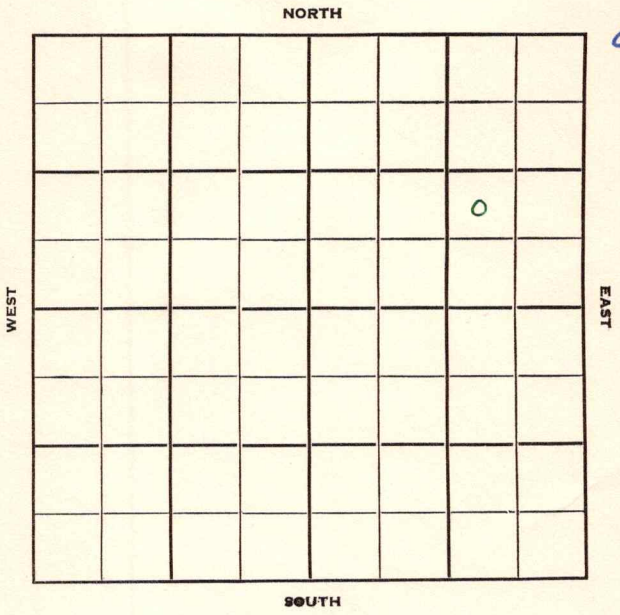

FORM 252-B
10M 8-51 TPCO.

Sumner KANSAS

Sec. 7 Twp. 33 R. 4 W

Well No. # 1 Wansch Farm

Stickle Drlg. & Harwood Oil Company

Patton Drlg. Contractor

Wildcat


Ft. from N. Line

990 Ft. from S. Line

990 Ft. from E. Line

Ft. from W. Line

NW SE NE

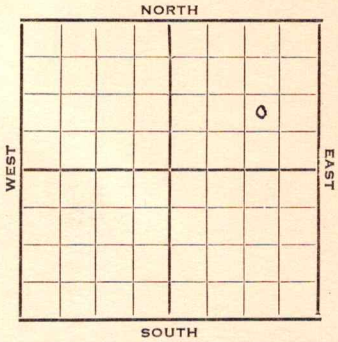


REPORT

| | |
|---|---|
| 1951 | Elev. 1256' |
| 11/21 | RUR |
| 1952 1/2 | Spud 1-22-51<br>D & A TD 4880' 8" @ 185'<br>Top. 2525' KC 3537'<br>DST 3540-88 open 1 hr. rec 685' SW<br>DST 3771-81 open 2 hr, rec 60' SGC & VSOCM<br>Miss 4258' Kh. 4539' Simp. 4659'<br>DST 4653-62 open 2 hr, rec 70' mud<br>DST 4661-73 open 2 hr, rec 60' mud<br>DST 4673-85 open 2 hr, rec 300' SW<br>Arb. 4829-80' TD<br>D & A |

ABANDONED

FORM 275 FOR SALE BY KANSAS BLUE PRINT CO.


County Sumner State Kansas

Sec. 7 (Blk. Twp.) 33 (Sur. Rge.) 4W Map No.

Operator Stickle Drlg. & Harwood Oil

Well No. 1 Farm Wansch

Elev. Location NW SE NE

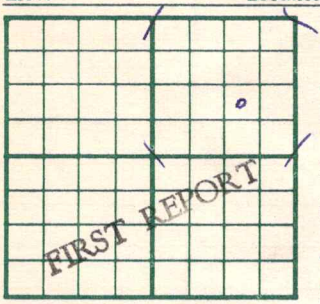


990 Ft. From S Line NE

990 Ft. From E Line Quarter

1st. Report NOV 21 1951

Completion

Remarks Patton Drlg. - Contr.

Spudding Date

Drlg. Data Wildcat

R U R

J. E. TYRA

FORM 275 FOR SALE BY KANSAS BLUE PRINT CO.


County Sumner State Kansas

Sec. 7 (Blk. Twp.) 33 (Sur. Rge.) 4W Map No.

Operator Stickle Drlg. & Harwood Oil

Well No. 1 Farm Wansch

Elev. 1256 Location NW SE NE

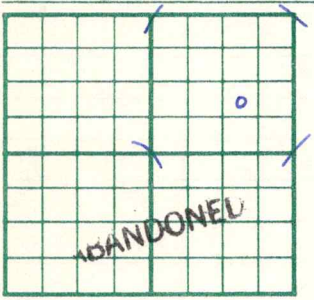


990 Ft. From S Line NE

990 Ft. From E Line Quarter

1st. Report

Completion JAN 2 1952

Remarks Wildcat

Patton Drlg. - Contr.

Spudding Date 1-22-51

Drlg. Data D & A TD 4880

8" @ 185 Top. 2525 KC 3537 DST 3540-88 open 1 hr. Rec. 685' sw DST 3771-81 open 2 hr. Rec. 60' sgc & vsocm Miss. 4258 Kh. 4539 Simp. 4659 DST 4653-62 open 2 hr. Rec. 70' mud DST 4661-73 open 2 hr. Rec. 60' mud DST 4673-85 open 2 hr. Rec. 300' sw Arb. 4829-80 TD D & A

J. E. TYRA