Sumner KANSAS


SECTION 17 TOWNSHIP 33S RANGE 4W

WELL NO. #1 Wooden

COMPANY Aurora Gasoline

NORTH SE SE NE

8

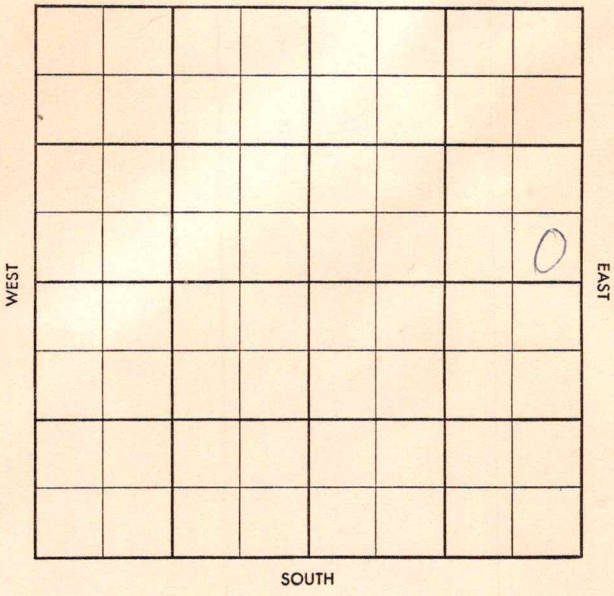

FORM 504-3 SUNRAY

WILDCAT

S-513-B

County Sumner Elev.

Sec. 17 Twp. 33 Rge. 4W

Company Aurora Gasoline

Farm Name Wooden No. 1


TOPS	DEPTH	LOG	DATUM
Anh.			
Tp.			
H.			
Tr.			
Dg.			
B. L.			
L.			
K.C.			
B.K.C.			
Ce.			
C.			
M.			
M.			
K.			
Mz.			
Mq.			
V.			
S.			
S.			
A.			
R.			
Pf.			
G.			
T.D.			

Loc. in Sec. SE SE NE

Geol.

Contr. Hilton Drlg.

Pool Wildcat

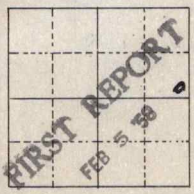

Date Comm. 2/1/58 (Skelly, Amerada-DHM)

8" @ 219 w/250, Drlg. 1280.

Co. Lse. No. Sec. T. R.

S-513-B

County Sumner Elev. 1255 DF 1259 GR

Sec. 17 Twp. 33 Rge. 4W

Company Aurora Gasoline

Farm Name Wooden No. 1

TOPS	DEPTH	LOG	DATUM
Anh.			
Tp.			
H.			
Tr.			
Dg.	3027		
B.L. 5721	3240		
L.			
K.C.	3567		
B.K.C.	3843		
Ce.			
C.			
M.	4318		
M.			
K.	4665		
Mz.			
Mq.			
V.			
S.	4746		
S.			
A.			
R.			
Pf.			
G.			
T.D.	4754	4756	

Loc. in Sec. SE SE NE

Geol. X

Contr. Hilton Drlg.

Pool Wildcat

ABANDONED

FEB 26 '58

Date Comm. 2/1/58 (Skelly, Amerada-DHM)

8" @ 219 w/250, Drlg. 1280.

FEB 12 '58 ∅ 3730 FEB 19 '58 ∅ 4578

FEB 26 '58

D&A

Co. Lse. No. Sec. T. R.