




Summer

Map No. **KANSAS** Sec. 5 Twp 33 R. 4<sup>W</sup>

Well No. 1 Belsey Farm  
Wentz et al Company

330 Ft. from N. Line  
\_\_\_\_ Ft. from S. Line  
\_\_\_\_ Ft. from E. Line  
330 Ft. from W. Line

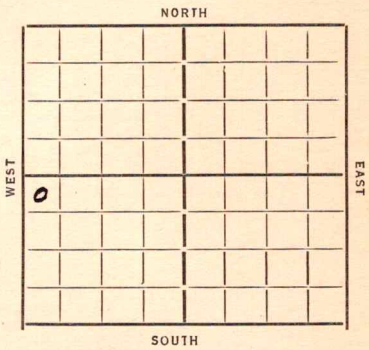

Date 1934

REPORT

6/13	Location
6/21	Cellar
6/28	Rgn Rotary
7/5	
7/12	Rig
7/19	Dly 440 15 1/2 97
7/26	1365 Pulled in Rig
8/2	Dly by tools
8/9	Dly 1795
8/16	" 2570
8/23	" 3480
8/30	" 3915
9/6	" 4000
9/13	SD 4098
9/20	Chat 4253 T Miss 4265
	Dly 4305
9/27	4437 7 sq drill stem
10/4	Dly 4480
10/11	A. Miss 4570 Wil 4655
	S.O. 4655-60 S.O. 4671-73 Dly 4690
10/17	Wilcox 4655 T D 4700 D O A

**ABANDONED**

KANSAS

Map No. 37 Sec. 5 Twp. 33 R. 4W

Well No. 1- Belsey

Wentz et al Company

Contractor

FIRST REPORT

SECTION PLAT

0			

330 Ft. from N. Line

\_\_\_\_\_ Ft. from S. Line

\_\_\_\_\_ Ft. from E. Line

330 Ft. from W. Line

Location ✓

Rig up \_\_\_\_\_

Drilling and Remarks:

RECORD

Cased \_\_\_\_\_ in., \_\_\_\_\_ ft.

Sand \_\_\_\_\_

Gas \_\_\_\_\_

Oil \_\_\_\_\_

Total Depth \_\_\_\_\_

PRODUCTION

1st 24 hrs. Nat. \_\_\_\_\_

1st 24 hrs. after shot \_\_\_\_\_

Gas \_\_\_\_\_ Cu. Ft.

Dry Hole \_\_\_\_\_

Abandoned \_\_\_\_\_

Date

6-13-34 19

ORVAL MANNSCHRECK Scout

Map No. 37 Sec. 5 Twp. 33 R. 4W

Well No. 1-Bellevue

Wentz etal Company

Contractor

ABANDONED

SECTION PLAT

330 Ft. from N. Line  
\_\_\_\_ Ft. from S. Line  
\_\_\_\_ Ft. from E. Line  
330 Ft. from W. Line

0			

Location \_\_\_\_\_

Rig up \_\_\_\_\_

Drilling and Remarks:

W & A

RECORD

Cased \_\_\_\_\_ in., \_\_\_\_\_ ft.

Sand Wilcox 4655

Gas \_\_\_\_\_

Oil \_\_\_\_\_

Total Depth 4700

PRODUCTION

1st 24 hrs. Nat. \_\_\_\_\_

1st 24 hrs. after shot \_\_\_\_\_

Gas \_\_\_\_\_ Cu. Ft.

Dry Hole \_\_\_\_\_

Abandoned \_\_\_\_\_

Date

10-17-37 19

ORVAL MANNSCHECK Scout