


Section 4 Township 33 Range 43W

Well No. #1 Hicks

Company Panhandle Eastern

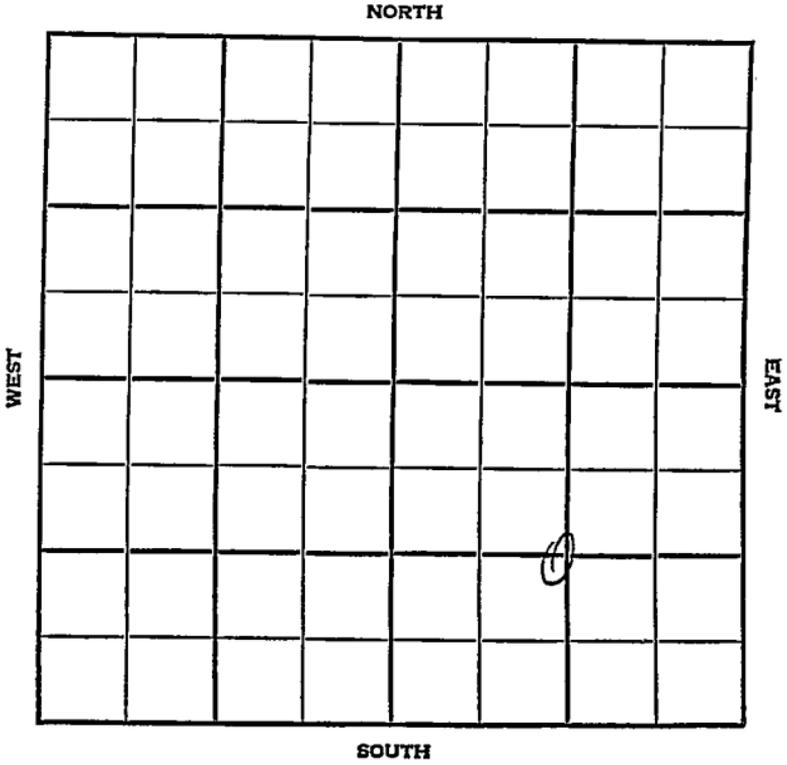

Morton KANSAS


SEC. 4 TWP. 33 R. 43W

WELL NO. 1 Hicks FARM

COMPANY Panhandle Eastern

CONTRACTOR Garvey Greenwood Pool

_____ Ft. from N. Line
 1320 _____ Ft. from S. Line
 1320 _____ Ft. from E. Line
 _____ Ft. from W. Line

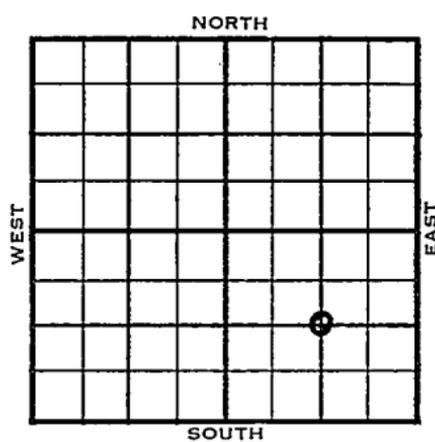

C SE/4


1955 ELEVATION 3617' REPORT

3/2 Spud 2-18-55
 10" @ 616'
 TD 3310'
 7" @ 3303'

3/30 Spud 2-18-55 Gas well TD 3310'
 10" @ 616' Waub. 2654' Top. 2878
 Lans. 3137 TD 3310 7" @ 3303 Co
 16/3232-36 40/3258-68 35/GWPH
 SP 3158 36/3140-49 28/3089-96
 1000 A 9,363,000 CFG SP 3208
 13,241,000 CFG SP 3040 20/3019-24
 3,418,000 CFG 64/3003-19 7,643,000
 CFG 2000 A 20,420,000 CFG
 SP 2985 Perf 2967-71 2953-59
 2944-49 2928-32 1500 A 1,987,000
 CFG Comp. 46,982,000 CFGPD 393#

COMPLETED

County Morton State Kansas
 Sec. 4 (Blk. 33 (Sur. 43W (Twp.) Map No.
 Operator Panhandle Eastern
 Well No. 1 Farm Hicks
 Elev. 3617 Location C SE/4

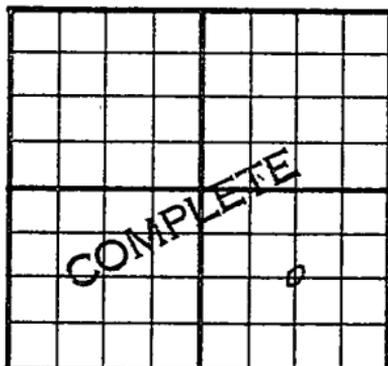

1320Ft. From S Line SE

1320Ft. From E Line Quarter

1st. Report

Completion MAR 30 1955Remarks Greenwood PoolGarvey - Contr.Spudding Date 2-18-55Drig. Data Gas well TD 331010" @ 616 Waub. 2654 Top. 2878Lans. 3137 TD 3310 7" @ 3303 C⁰16/ 3232-36 40/ 3258-68 35 gwphSP 3158 36/ 3140-49 28/ 3089-961000 A 9,363,000 cfg SP 320813,241,000 cfg SP 3040 20/ 3019-243,418,000 cfg 64/ 3003-19 7,643,000 cfg2000 A 20,420,000 cfg SP 2985perf/ 2967-71 2953-59 2944-492928-32 1500 A 1,987,000 cfgComp. 46,982,000 cfgpd 393#

FABEN GILSTRAF

