

Map No. KANSAS Sec.

Twp.

R.

Well No.

Farm

Company

NORTH

WEST

EAST

SOUTH

Location

Drilling Remarks

Rig Up

Drilling Remarks

RECORD

Cased in. ft.

Sand

Gas

Oil

Total Depth

PRODUCTION

1st 24 hrs. Nat.

1st 24 hrs. after shot


Gas cu. ft.

Dry Hole

Abandoned

Morton
 Map No. KANSAS Sec. 4 Twp. 33 R. 39^w
 Well No. 1- A. O. Mangels Farm
Argus Gas Company

NORTH

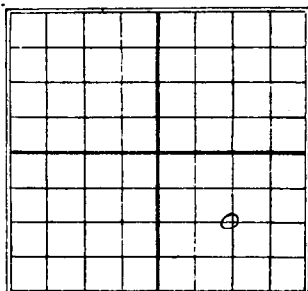

Ft. from N. Line

1320 Ft. from S. Line

1320 Ft. from E. Line

1930 Ft. from W. Line

Date	REPORT
5/21	Doc.
5/28	
6/4	Bldg. rig
6/11	Riggy up
6/18	hrlg. 1840'
6/25	" 2484'
7/2	Pust 2527'
7/9	
7/16	Slg. out 2527'
7/23	hrlg. 2890'
	Est. 500 gas.
7/30	hrlg. 3250'
8/16	Same 2527-2773
	TD 3312
	1 1/2 M gas
	Comp.


Map No. KANSAS Sec. 4 Twp. 23 R. 19W

Well No. 10000

Engle Gas Company

Contractor

SECTION PLAT

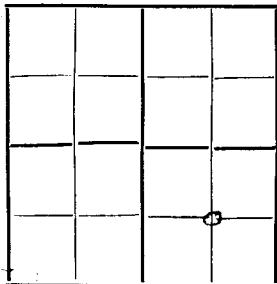

.....Ft. from N. Line

1320 Ft. from S. Line

1320 Ft. from E. Line

.....Ft. from W. Line

FIRST REPORTS

Location ✓

Rig up

Drilling and Remarks:

RECORD

Cased.....in., ...ft.

Sand.....

Gas.....

Oil.....

Total Depth.....

PRODUCTION

1st 24 hrs. Nat.....

1st 24 hrs. after shot.....

Gas.....Cu. Ft.

Dry Hole.....

Abandoned.....

Date

MAY 21 1930

192


Scout

Map No. KANSAS Sec. 4 Twp. 33 R. 39 W

Well No. 1 E. C. Mangella
Argus Gas Company

Contractor

SECTION PLAT

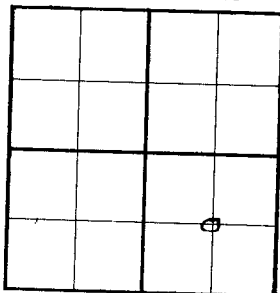

_____ Ft. from N. Line

1820 Ft. from S. Line

1820 Ft. from E. Line

_____ Ft. from W. Line

COMP

Location _____

Rig up _____

Drilling and Remarks:

1 1/2 M Gas.

RECORD

Cased _____ in., _____ ft.

Sand 2527-2729

Gas _____

Oil _____

Total Depth 3312

PRODUCTION

1st 24 hrs. Nat. _____

1st 24 hrs. after shot _____

Gas _____ Cu. Ft.

Dry Hole _____

Abandoned _____

Date

AUG 6 1930
19

S. J. LEWIS

Scout