SIDE ONE

STATE CORPORATION COMMISSION OF KANSAS
OIL & GAS CONSERVATION DIVISION
WELL COMPLETION OR RECOMPLETION FORM
ACO-1 WELL HISTORY
DESCRIPTION OF WELL AND LEASE

Operator: License # 5447
Name Cities Service Oil & Gas Corp.
Address 3545 NW 58th Street
Oklahoma City, Oklahoma
City/State/Zip 73112

Purchaser CITGO -

Operator Contact Person Raymond Hui
Phone (405) 949-4432

Contractor: License #
Name Wakefield Drilling Company

Wellsite Geologist Andrew Howell
Phone (405) 949-4400

Designate Type of Completion
X New Well __ Re-Entry __ Workover

X Oil __ SWD __ Temp Abd
__ Gas __ Inj __ Delayed Comp.
__ Dry __ Other (Core, Water Supply etc.)

If OWWO: old well info as follows:
Operator
Well Name
Comp. Date Old Total Depth

WELL HISTORY

Drilling Method:
X Mud Rotary __ Air Rotary __ Cable

12/26/86 1/7/87 2/27/87
Spud Date Date Reached TD Completion Date

5130' 5086'
Total Depth PBTD

Amount of Surface Pipe Set and Cemented at 1391 feet
Multiple Stage Cementing Collar Used? __ Yes X No
If yes, show depth set feet
If alternate 2 completion, cement circulated
from feet depth to w/ SX cmt
Cement Company Name
Invoice #

API NO. 15- 129-20839

County Morton

NE NE NE Sec. 18 Twp. 33S Rge. 43 __ East X West

4822 Ft North from Southeast Corner of Section
474 Ft West from Southeast Corner of Section
(Note: Locate well in section plat below)


Lease Name Bookstore A Well # 1

Field Name Tumorrow

Producing Formation Morrow L-3

Elevation: Ground 3655' KB 3663'

Section Plat

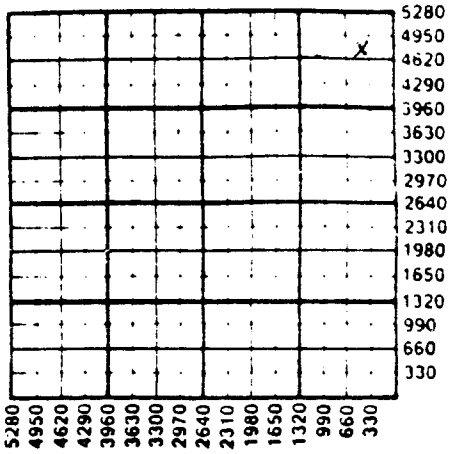


X WATER SUPPLY INFORMATION

Disposition of Produced Water: __ Disposal
Docket # __ Repressuring

Questions on this portion of the ACO-1 call:
Water Resources Board (913) 296-3717

Source of Water:
Division of Water Resources Permit # T26-495A

X Groundwater 4695 Ft North from Southeast Corner
(Well) 4720 Ft West from Southeast Corner of
Sec 17 Twp 33 Rge 43 __ East X West

__ Surface Water Ft North from Southeast Corner
(Stream, pond etc.) Ft West from Southeast Corner
Sec Twp Rge __ East __ West

__ Other (explain)
(purchased from city, R.W.D. #)

INSTRUCTIONS: This form shall be completed in triplicate and filed with the Kansas Corporation Commission, 200 Colorado Derby Building, Wichita, Kansas 67202, within 120 days of the spud date of any well. Rule 82-3-130, 82-3-107 and 82-3-106 apply.
Information on side two of this form will be held confidential for a period of 12 months if requested in writing and submitted with the form. See rule 82-3-107 for confidentiality in excess of 12 months.
One copy of all wireline logs and drillers time log shall be attached with this form. Submit CP-4 form with all plugged wells. Submit CP-111 form with all temporarily abandoned wells.