

Jan

SIDE ONE

STATE CORPORATION COMMISSION OF KANSAS
OIL & GAS CONSERVATION DIVISION

WELL COMPLETION OR RECOMPLETION FORM
ACO-1 WELL HISTORY

DESCRIPTION OF WELL AND LEASE

Operator: License # 04511
Name William H. Davis
Address 2800 Mid-Continent Tower
City/State/Zip Tulsa, Ok 74103

Purchaser n/a

Operator Contact Person Mike Purdum
Phone 918 587 7782

Contractor: License # 5107
Name H-30 Drilling, Inc.

Wellsite Geologist
Phone

Designate Type of Completion

- New Well Re-Entry Workover
- Oil SWD Temp Abd
- Gas Inj Delayed Comp.
- Dry Other (Core, Water Supply etc.)

If OWWO: old well info as follows:

Operator
Well Name
Comp. Date Old Total Depth

WELL HISTORY

Drilling Method:

- Mud Rotary Air Rotary Cable

8-26-89 9-6-89
Spud Date Date Reached TD Completion Date
4502
Total Depth PBTD

Amount of Surface Pipe Set and Cemented at 301 feet
Multiple Stage Cementing Collar Used? Yes No
If yes, show depth set feet
If alternate 2 completion, cement circulated from feet depth to w/ SX cmt

API NO. 15-077-21-197

County Harper

C SW NE Sec 5 Twp 33 Rge 5 East West

3330 Ft North from Southeast Corner of Section
1980 Ft West from Southeast Corner of Section

(Note: Locate well in section plat below)


Lease Name Ransom Well # 1

Field Name

Producing Formation Waiting on completion

Elevation: Ground 1347 KB 1356

Section Plat

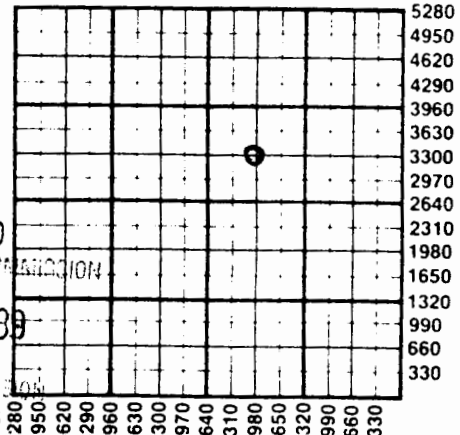

OCT 03 1988

RECEIVED STATE CORPORATION COMMISSION

SEP 29 1988

KANSAS GEOLOGICAL SURVEY

WICHITA CANNON

WATER SUPPLY INFORMATION

Disposition of Produced Water: Disposal Repressuring
Docket #

Questions on this portion of the ACO-1 call:

Water Resources Board (913) 296-3717

Source of Water:

Division of Water Resources Permit #

Groundwater Ft North from Southeast Corner (Well) Ft West from Southeast Corner Sec Twp Rge East West

Surface Water 330 Ft North from Southeast Corner (Stream, pond etc) 2310 Ft West from Southeast Corner Sec 6 Twp 33 Rge 5 East West

Other (explain) (purchased from city, R.W.D. #)

INSTRUCTIONS: This form shall be completed in duplicate and filed with the Kansas Corporation Commission, 200 Colorado Derby Building, Wichita, Kansas 67202, within 90 days after completion or recompletion of any well. Rule 82-3-130 and 82-3-107 apply. Information on side two of this form will be held confidential for a period of 12 months if requested in writing and submitted with the form. See rule 82-3-107 for confidentiality in excess of 12 months. One copy of all wireline logs and drillers time log shall be attached with this form. Submit CP-4 form with all plugged wells. Submit CP-111 form with all temporarily abandoned wells.