

STATE CORPORATION COMMISSION OF KANSAS
OIL & GAS CONSERVATION DIVISION
WELL COMPLETION OR RECOMPLETION FORM
ACO-1 WELL HISTORY
DESCRIPTION OF WELL AND LEASE

Operator: License # 04511
Name William H. Davis
Address 1520 Liberty Tower
.....
City/State/Zip Oklahoma City, OK 73102

Purchaser

Operator Contact PersonMike Purdum.....
Phone(405) 236-4029.....

Contractor License # 5107
Name H-30 Drilling, Inc.

Wellsite Geologist.....
Phone.....

Designate Type of Completion

X	New Well	Re-Entry	Workover
---	----------	----------	----------

Oil	SWD	Temp	Abd
Gas	Inj	<u>X</u>	Delayed Comp.
Dry	Other (Core, Water Supply etc.)		

If OWWO: old well info as follows:

Operator
Well Name
Comp. DateOld Total Depth.....

WELL HISTORY

Drilling Method:

☒ Mud Rotary ☐ Air Rotary ☐ Cable

5-17-89	5-23-89	
.....		
Spud Date	Date Reached TD	Completion Date

3630'	
Total Depth	PBTD

Amount of Surface Pipe Set and Cemented at.....feet
Multiple Stage Cementing Collar Used? Yes X No
If yes, show depth set.....feet
If alternate 2 completion, cement circulated
from.....feet depth to.....w/.....SX cmt
Cement Company Name
Invoice #

API NO. 15-077-21,195.....

County.....Harper.....

..C-SE SW. Sec. 5... Twp. 33S Rge. 5... X East
West

660..... Ft North from Southeast Corner of Section
3330..... Ft West from Southeast Corner of Section
(Note: Locate well in section plat below)


Lease Name.....Wethington.....Well #.....5-1.....

Field Name.....

Producing Formation. Waiting on Completion.

Elevation: Ground.....1333.....KB.....1342.....

Section Plat

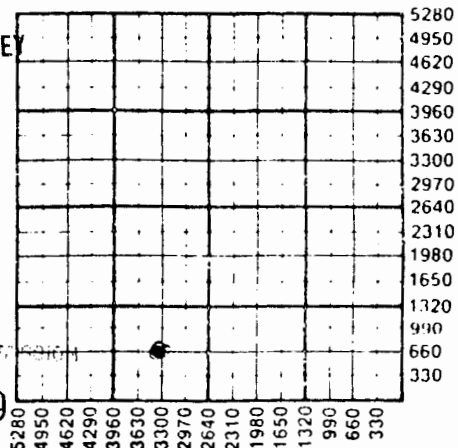

KANSAS GEOLOGICAL SURVEY
WICHITA BRANCH

OCT 12 1960

RECEIVED

SEP 13 1989

WATER SUPPLY INFORMATION

Disposition of Produced Water: _____ Disposal
Docket # Repressuring

Questions on this portion of the ACO-1 call:

Water Resources Board (913) 296-3717

Source of Water:

Division of Water Resources Permit #.....

Groundwater.....Ft North from Southeast Corner
(Well)Ft West from Southeast Corner of
Sec Twp Rge East West

X Surface Water. 330Ft North from Southeast Corner
(Stream, pond etc) 2310Ft West from Southeast Corner
Sec 6 Twp 33 Rge 5 East x West

Other (explain).....
(purchased from city, R.W.D. #)

INSTRUCTIONS: This form shall be completed in triplicate and filed with the Kansas Corporation Commission, 200 Colorado Derby Building, Wichita, Kansas 67202, within 120 days of the spud date of any well. Rule 82-3-130, 82-3-107 and 82-3-106 apply.

Information on side two of this form will be held confidential for a period of 12 months if requested in writing and submitted with the form. See rule 82-3-107 for confidentiality in excess of 12 months.

One copy of all wireline logs and drillers time log shall be attached with this form. Submit CP-4 form with all plugged wells. Submit CP-111 form with all temporarily abandoned wells.