

STATE CORPORATION COMMISSION OF KANSAS  
OIL & GAS CONSERVATION DIVISION  
WELL COMPLETION OR RECOMPLETION FORM  
ACO-1 WELL HISTORY  
DESCRIPTION OF WELL AND LEASE

Operator: License # 5020  
Name Rine Exploration Company  
Address Suite #645  
300 W. Douglas  
City/State/Zip Wichita, KS 67202-2904

Purchaser.....

Operator Contact Person M. Bradford Rine  
Phone 316/262-5418

Contractor: License # 5929  
Name Duke Drilling Company, Inc.

Wellsite Geologist Paul Barker  
Phone 405/232-3070

Designate Type of Completion  
 New Well  Re-Entry  Workover  
 Oil  SWD  Temp Abd  
 Gas  Inj  Delayed Comp.  
 Dry  Other (Core, Water Supply etc.)

If ONWO: old well info as follows:  
Operator.....  
Well Name.....  
Comp. Date.....Old Total Depth.....


WELL HISTORY

Drilling Method:  
 Mud Rotary  Air Rotary  Cable  
07/07/88 07/14/88  
Spud Date Date Reached TD Completion Date  
3645' 3607'  
Total Depth PBTD  
Amount of Surface Pipe Set and Cemented at 266 feet  
Multiple Stage Cementing Collar Used?  Yes  No  
If yes, show depth set.....feet  
If alternate 2 completion, cement circulated from.....feet depth to.....w/.....SX cmt  
Cement Company Name.....  
Invoice #.....

API NO. 077-21,176  
County Harper  
100' W of CNW 4 Sec 8 Twp 33S Rge 5W East  
..... X West  
3960 Ft North from Southeast Corner of Section  
4060 Ft West from Southeast Corner of Section  
(Note: Locate well in section plat below)

Lease Name Salser Well # 1-8  
Field Name Freeport South Revival  
Producing Formation Stalnaker  
Elevation: Ground 1328 KB 1336

Section Plat

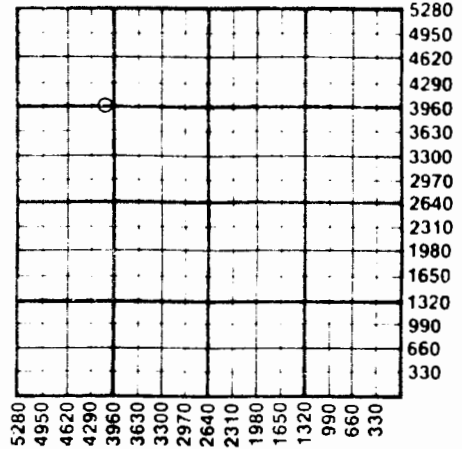

WATER SUPPLY INFORMATION

Disposition of Produced Water:  Disposal  
Docket # .....  Repressuring

Questions on this portion of the ACO-1 call:  
Water Resources Board (913) 296-3717

Source of Water:  
Division of Water Resources Permit #.....  
 Groundwater.....Ft North from Southeast Corner  
(Well) .....Ft West from Southeast Corner of  
Sec Twp Rge East West  
 Surface Water 4950 Ft North from Southeast Corner  
(Stream, pond etc) 3960 Ft West from Southeast Corner  
Sec 7 Twp 33S Rge 5W East X West  
 Other (explain).....  
(purchased from city, R.W.D. #)

INSTRUCTIONS: This form shall be completed in triplicate and filed with the Kansas Corporation Commission, 200 Colorado Derby Building, Wichita, Kansas 67202, within 120 days of the spud date of any well. Rule 82-3-130, 82-3-107 and 82-3-106 apply. Information on side two of this form will be held confidential for a period of 12 months if requested in writing and submitted with the form. See rule 82-3-107 for confidentiality in excess of 12 months. One copy of all wireline logs and drillers time log shall be attached with this form. Submit CP-4 form with all plugged wells. Submit CP-111 form with all temporarily abandoned wells.

All requirements of the statutes, rules and regulations promulgated to regulate the oil and gas industry have been fully complied with and the statements herein are complete and correct to the best of my knowledge.

Signature M. Bradford Rine  
(M. Bradford Rine)  
Title President & Geologist Date 08/24/88

Subscribed and sworn to before me this 24th day of August 1988  
Notary Public Ginger L. Kelley  
(Ginger L. Kelley)  
Date Commission Expires June 11, 1990

K.C.C. OFFICE USE ONLY  
 Letter of Confidentiality Attached  
 Wireline Log Received  
 Drillers Timelog Received  
Distribution  
 KCC  SWD/Rep  NGPA  
 KGS  Plug  Other  
(Specify)

GINGER L. KELLEY  
NOTARY PUBLIC  
STATE OF KANSAS  
My Appl. Exp. 06-11-90