


Section 3 Township 33 Range 5 W

Well No. " 1 Jordan

Company Aurora

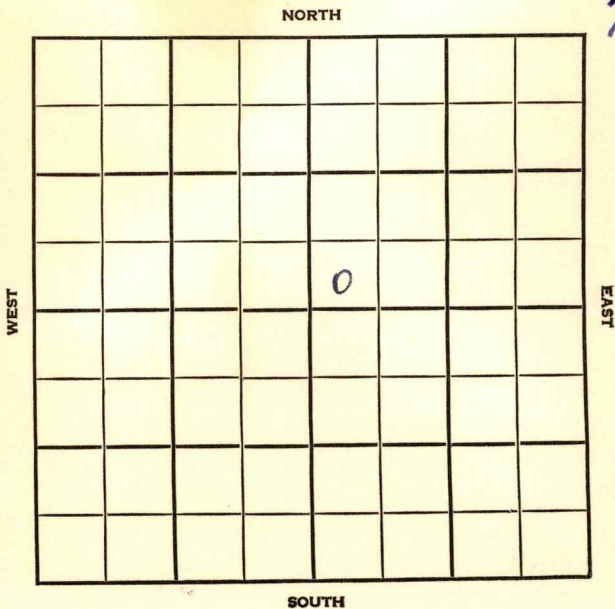

Harper

KANSAS

SEC.	TWP.	R.
3	33	5 W

WELL NO. # 1 Jordan FARM

COMPANY

Aurora

CONTRACTOR J-S-F
Wildcat


_____ Ft. from N. Line

330 _____ Ft. from S. Line

_____ Ft. from E. Line

330 _____ Ft. from W. Line

SW SW NE

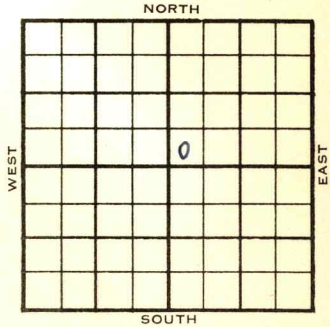

1954	ELEVATION 1316'	REPORT
------	--------------------	--------

12/15 Spud 12-10-54
8" @ 349 WOC

1955
1/12 Spud 12-10-54 D & A TD 4885
8" @ 349 Heeb 3036 Stal. 3400
Lans. 3672 B KC 3930 Miss. 4366
Kh. 4766 Simp 4864
TD 4885' D & A

ABANDONED

