

Section 5 Township 33 Range 43WWell No. #1 Light "B"Company Cities Service & Anerada

NORTH

				0			

WEST

EAST

SOUTH

Morton

KANSAS

SEC.	5	TWP.	33	R.	43W
------	---	------	----	----	-----

WELL NO.

#1 Light "B"

FARM

COMPANY

Cities Service & Amerada

CONTRACTOR

Greenwood Pool

Ft. from N. Line


330

Ft. from S. Line

Ft. from E. Line

330

Ft. from W. Line

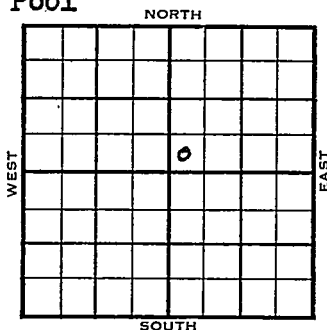

SW SW NE

ELEVATION

REPORT

1953

3640'

10/7

8" @ 600'

WOC

10/14

RTD 3350

11/11

Spud 10-5-53

Gas Well

TD 3350'

8" @ 600

Top 2920', L ans 3187'

TD 3350'

5" @ 3348'

CO to 3311

70/3240-54, 20/3232-36, 30/3222-28,

20/3212-16, 60/3192-3204, 6000A

SSG & 350 gwph

CO to 3140

50/3098-3108, 70/3068-82, 30/3058-64,

4500A

5,350,000 gas,

SP 3037, 20/3024-28, 40/3010-18,

40/2998-3006, 40/2978-86, 20/2960-64,

5000A, 5,540,000 gas, 4000A

5,900,000 gas

Shut in 2 days, 2 hrs. BD 7,150,000


gas,

Comp. 11,600,000 gas, 435#

3640 3640
 2920 3187
 +720 = 453

COMPLETED

County Morton State Kansas
 Sec. 5 (Blk.) 33 (Sur.) 43W Map No.
 Operator Cities & Service & Amerada
 Well No. 1 Farm Light "B"
 Elev. 3640 Location SW SW NE

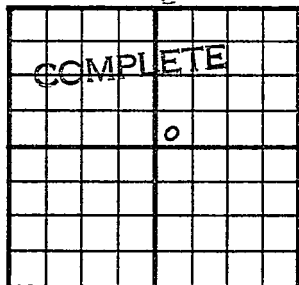

330 Ft. From S Line NE
330 Ft. From W Line Quarter
 Ist. Report
 Completion NOV 11 1953
 Remarks Greenwood Gas Pool

Spudding Date 10-5-53

Drig. Data Gas well TD 3350
8" @ 600 Top. 2920 Lans. 3187
TD 3350 5" @ 3348 CO to 3311
70/ 3240-54 20/ 3232-36 30/ 3222-28
20/ 3212-16 60/ 3192-3204 6000 A
SSG & 350 gwph CO to 3140 50/ 3098-3108
70/ 3068-82 30/ 3058-64 4500 A
5,350,000 gas SP 3037 20/ 3024-28
40/ 3010-18 40/ 2998-3006 40/ 2978-86
20/ 2960-64 5000 A 5,540,000 gas
4000 A 5,900,000 gas Shut in 2 days
2 hr. BD 7,150,000 gas
Comp. 11,600,000 gas 435#

J. G. McGEHEE