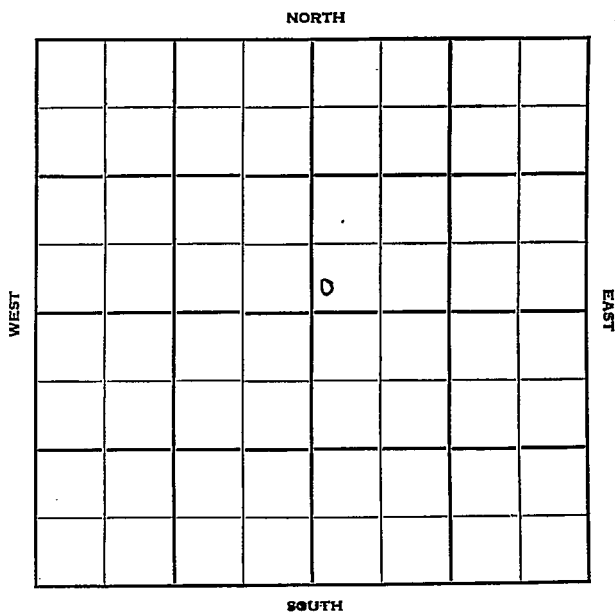


Section 5 Township 33 Range 40WWell No. 15 HuntCompany Panhandle Eastern

Morton

KANSAS

Sec. 5 Twp. 33 R. 40W

Well No. #15 Hunt Farm

Panhandle Eastern Company

Hugoton Pool Contractor


 Ft. from N. Line

127' Ft. from S. Line

 Ft. from E. Line

111' Ft. from W. Line

SW SW NE

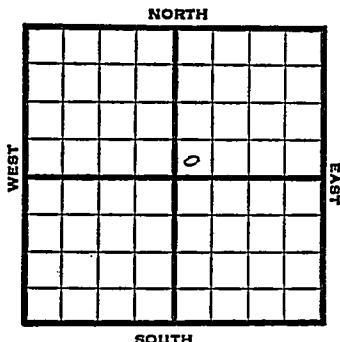

1951

Elev. 3346' REPORT

7/25

Location

10/31

Spud 7-30-51

Gas Well TD 2456

10" @ 506 7" @ 2290

TD 2456 PB 2411

Kri 2299 Win 2361

Ft. Riley 2432

14,000 A Comp. 9,963,000 gas

COMPLETED

County **Morton** State **Kansas**

Sec. 5 (Blk. Twp.) 33 (Sur. Rge.) 40W Map No.

Operator Panhandle Eastern

Well No. 15 Farm Hunt

Elev.	Location	SW	SW	NE
-------	----------	----	----	----

FIRST REPORT	
o	

127 Ft. From S Line NE

177	Ft. From	W	Line	Quarter
-----	----------	---	------	---------

1st. Report JUL 25 1951

Completion _____

Remarks


Spudding Date _____

Drlg. Data Hugoton Pool

Location

J. E. TYRA

County Morton State Kansas
 Sec. 5 (Blk.) 33 (Sur.) 40W Map No. _____
 Operator Panhandle Eastern
 Well No. 1-5 Farm Hunt
 Elev. 3346 Location SW SW NE

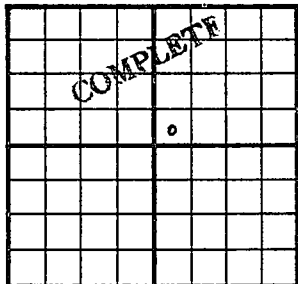

127 Ft. From S Line NE
111 Ft. From W Line Quarter
 Ist. Report _____
 Completion OCT 31 1951
 Remarks Hugoton Pool
 Spudding Date 7-30-51

Drlg. Data Gas well TD 2456
10" @ 506 7" @ 2290 TD 2456 PB 2411
Kri. 2299 Win. 2361 Ft. Riley 2432
14000 A Comp. 9,963,000 gas

J. E. TYRA