KANSAS


FORM 51 5M 11-44 PETROL

Stevens County

Section 5 Township 33 Range 36W

Well No. #1 Flowers

Company Northern Natural Gas

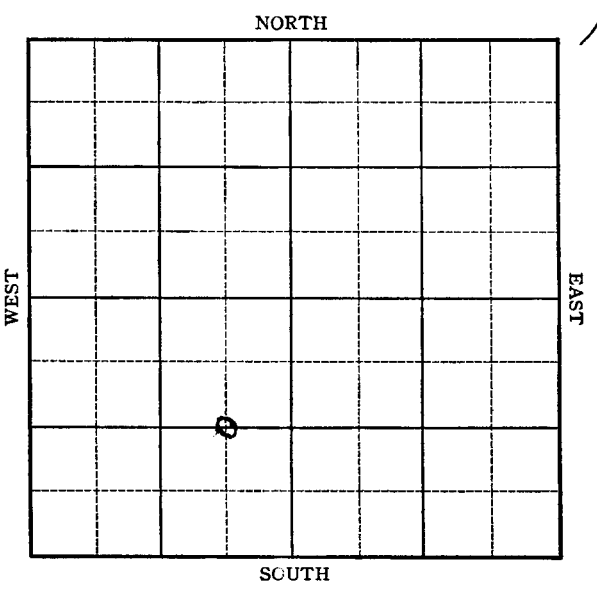

FORM 252-A
5M 8-45 PETROL


Stevens County ✔

Sec. 5 Twp. 33 R. 36-W

Well No. #1 Flowers Farm

Northern Natural Gas Company

Hugoton

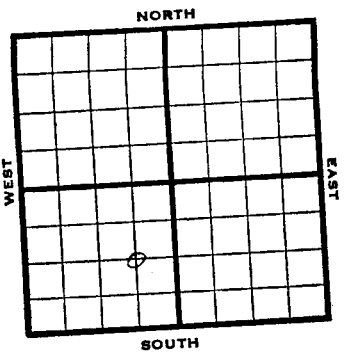

_____ Ft. from N. Line

1320 Ft. from S. Line

660 Ft. from E. Line

_____ Ft. from W. Line

C E½ SW

Elev. 3087

1946	REPORT
6/19	RUR
6/26	10" @ 592' Drlg 2457'
7/3	7" @ 2615-25 TD RUST
7/9	TD 2828-233 of 5" Perf liner @ 2828'
7/16	" " "
7/23	" " "
7/30	12500 acid
8;/6	" "
8/11	" "
8/21	7" @ 2615 233' of 5" perf. liner @ 2828 TD 2828 12,500 acid. 27,397,000 Gas. 388# R Pr.

COMPLETE

FORM 56 200 BRS. 1-44 PETROL

KANSAS

Kansas

Pool Name Hugoton

Map No. Sec. 5 Twp. 33 R. 36W

Well No. 1 Flowers


Northern Natural Gas Company

COMPLETED Contractor

C E½ SW

E 1,3057

SECTION PLAT

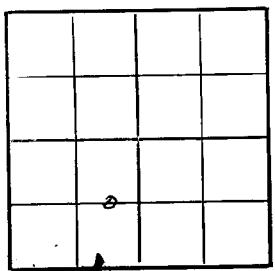

Ft. from N. Line

1320 Ft. from S. Line

660 Ft. from E. Line

Ft. from W. Line

Stevens County

Location

Rig up

Drilling and Remarks:

7" @ 2613'

288' of 5" Perf liner @ 2824'

12,500 acid

27,387,000 Gas

988 # RP

RECORD

Cased in., ft.

Sand

Gas

Oil

Total Depth 2828

PRODUCTION

1st 24 hrs. Nat.

1st 24 hrs. after shot

Gas Cu. Ft.

Dry Hole

Abandoned

Date

AUG 21 1946 19

S. J. LEWIS Scout

FORM 26 200 BKS. 2-44 PETROL

Kansas Pool Name Hugoton

Map No. ____ Sec. 5 Twp. 33 R. 36W


Well No. 1 Flowers

Northern Natural Gas Company

FIRST REPORT Contractor

C E ½ SW

SECTION PLAT

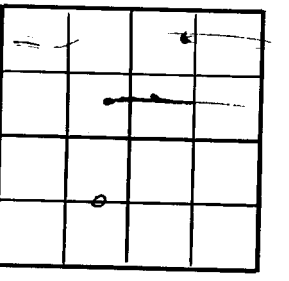

____ Ft. from N. Line

1320 Ft. from S. Line

660 Ft. from E. Line

____ Ft. from W. Line

Stevens County

Location

Rig up

Drilling and Remarks:

RUR

RECORD

Cased ____ in., ____ ft.

Sand

Gas

Oil

Total Depth

PRODUCTION

1st 24 hrs. Nat.

1st 24 hrs. after shot

Gas ____ Cu. Ft.

Dry Hole

Abandoned

Date

JUN 19 1946 19 ____ S. J. LEWIS Scout