


Section 5 Township 33 Range 33W

Well No. #1 Bryant

Company Cabot Carbon

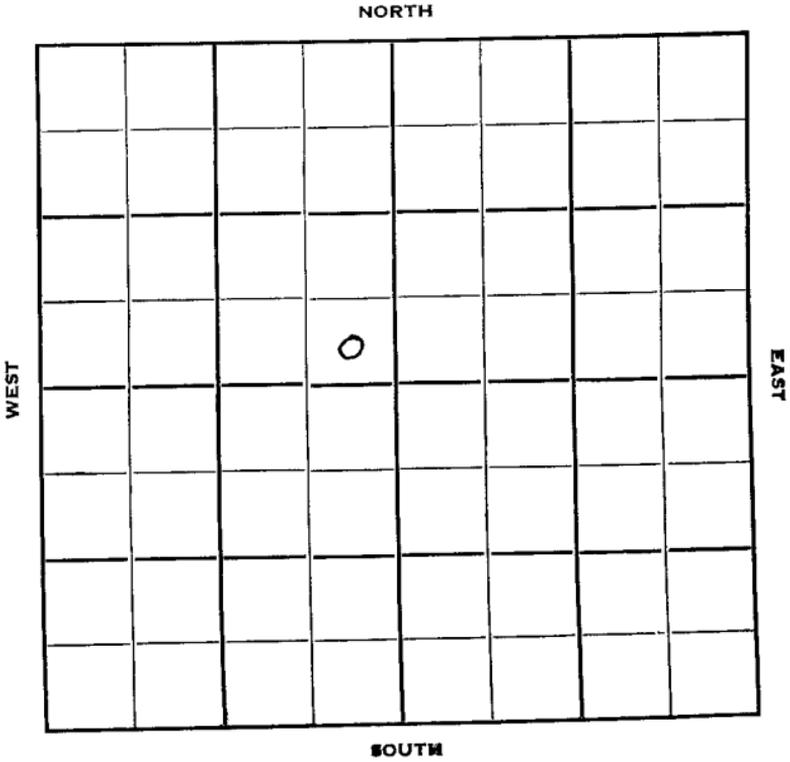

Sec. 5 Twp. 33 R. 33W ✓

Well No. #1 Bryant Farm

Cabot Carbon Company

Bolin - Contr. Contractor

Hugoton Pool


Ft. from N. Line

330' Ft. from S. Line

330' Ft. from E. Line

Ft. from W. Line

SE SE NW

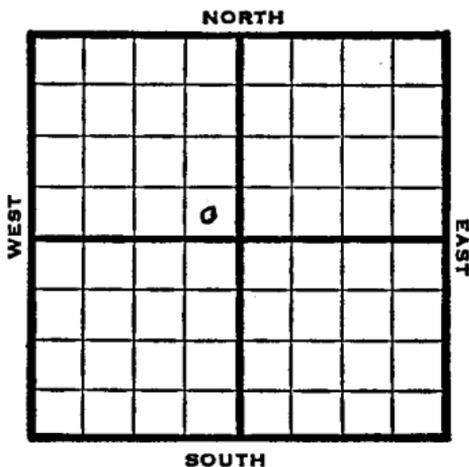

1950

Elev 2839 REPORT

0/4

Drlg.

12/6

10" @ 488

7" @ 2563

TD 2650

Her 2561

13000 A

Comp 14,752,000 gas

Completed

2-11-50



