

KANSAS


Seward

Section 5 Township 33 Range 34WWell No. 1 HitchCompany Panhandle Eastern

Hugoton

NORTH

WEST

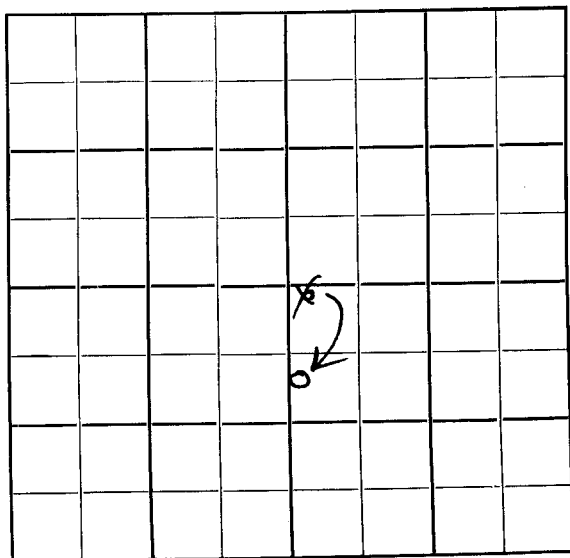

EAST

SOUTH

KANSAS

Seward

Sec. 5 Twp. 33 R. 34W ✓

Well No. #1 Hitch Farm
Panhandle Eastern Company

Hugoton Pool

800


79 Ft. from N. Line

Ft. from S. Line

Ft. from E. Line

160

205 Ft. from W. Line

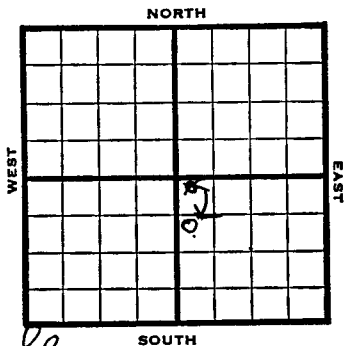

~~NW SE~~

new well

1949 Elev 2900' REPORT

5/4	Location
5/10	10" @ 497' Drlg. 2545'
5/18	TD 2585 7" @ 2575
5/25	"
6/1	TD 2735' 180' of 5" Perf liner @ 2735'
6/7	"
6/15	"
6/21	"
6/28	"
7/6	"
7/13	TD 2735' 7" @ 2575' 180' of 5" Perf Liner @ 2735' 1,036,000 Gas 440# R Pr. Comp

COMPLETED

Map No. _____ Sec. 5 Twp. 33 R. 34W

Well No. 1 Hitch

Panhandle Eastern

Company

FIRST REPORT

Contractor

NW SE

SECTION FLAT

79 Ft. from N. Line

_____ Ft. from S. Line

_____ Ft. from E. Line

203 Ft. from W. Line

		6	

Seward County

Location ✓

Rig up _____

Drilling and Remarks:

RECORD

Cased _____ in., _____ ft.

Sand _____

Gas _____

Oil _____

Total Depth _____

PRODUCTION

1st 24 hrs. Nat. _____

1st 24 hrs. after shot _____

Gas _____ Cu. Ft.

Dry Hole _____

Abandoned _____

Date

MAY 4 1949 19

S. J. LEWIS Scout

Hugoton

Kansas

Map No. _____ Sec. 5 Twp. 33 R. 34W

Well No. 1 Hitch

Panhandle Eastern

Company

CORRECTION

Contractor

C W L NW SE


SECTION PLAT

800 Ft. from N. Line

Ft. from S. Line

Ft. from E. Line

100 Ft. from W. Line

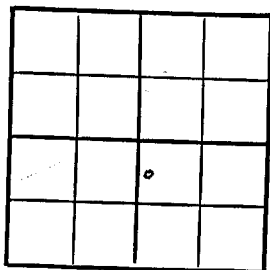

Seward County

Location _____

Rig up _____

Drilling and Remarks:

Reported

NW SE

RECORD

Cased _____ in., _____ ft.

Sand _____

Gas _____

Oil _____

Total Depth _____

PRODUCTION

1st 24 hrs. Nat. _____

1st 24 hrs. after shot _____

Gas _____ Cu. Ft.

Dry Hole _____

Abandoned _____

Date

MAY 11 1949

19

S. J. LEWIS

Scout

Map No. ✓ Sec. 5 Twp. 33 R. 34W

Well No. 1 Hitch

Panhandle Eastern Company

COMPLETE

Contractor

C N L NW SE


E 1,2800
SECTION PLAT

800 Ft. from N. Line

 Ft. from S. Line

 Ft. from E. Line

100 Ft. from W. Line

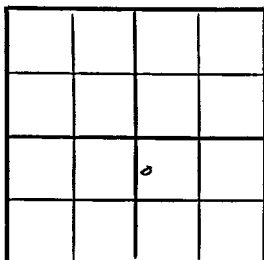

Seward County

Location

Rig up

Drilling and Remarks:

7' C 2525
180' 2 1/2" Fly line
C 2735
1, 236, 000 - 600
*470 * R/A*

RECORD

Cased in., ft.

Sand

Gas

Oil

Total Depth 2735

PRODUCTION

1st 24 hrs. Nat.

1st 24 hrs. after shot

Gas Cu. Ft.

Dry Hole

Abandoned

Date

JUL 1 3 1949

19

S. J. LEWIS

Scout