


Section 5 Township 33-23 Range 39W
Well No. #1-5 Anderson
Company Panhandle Eastern

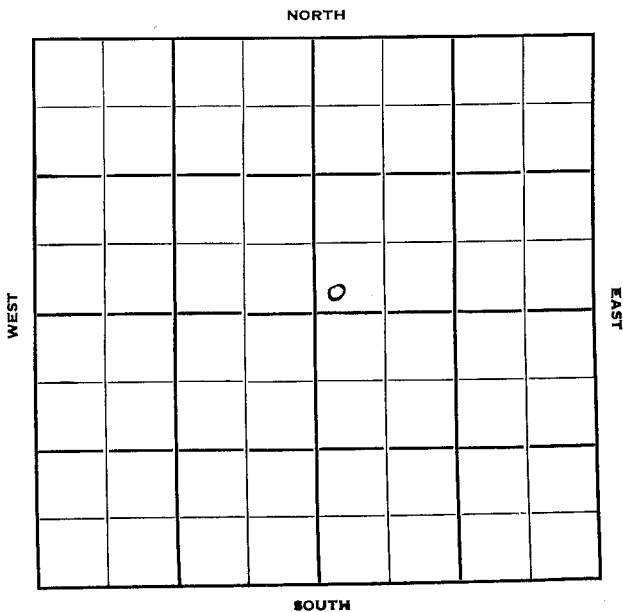

Hamilton

KANSAS

Sec. 5 Twp. 23 3 3 R. 39W ✓

Well No. #1-5 Anderson Farm

Panhandle Eastern Company

Kuhn Drlg. Contractor

Hugoton Pool

Ft. from N. Line

150'

Ft. from S. Line


Ft. from E. Line

150'

Ft. from W. Line

SW NE

Gas Well

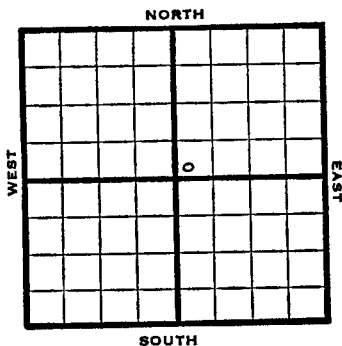

1950

Elev 3239

REPORT

4/26

Spud 4-20-50

10" @ 563'

Drlg. 1370'

10/11

10" @ 563

7" @ 2387

TD 2597

Hol 2350

Her 2390-2405

Krider 2417-75

Win 2490-2530

Towanda 2557

Comp. 869,000 gas

Del test

Completed

COMPLETED

Kansas

Hugoton Pool


Map No. _____ Sec. 5 Twp. 23 R. 39Well No. 1-5 Anderson

_____ Panhandle Eastern _____ Company

_____ Contractor

SW NE

SECTION PLAT

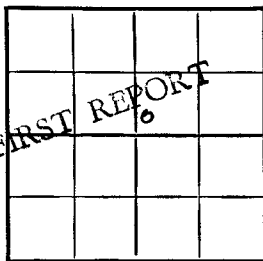

_____ Ft. from N. Line

150 Ft. from S. Line

_____ Ft. from E. Line

150 Ft. from W. LineHamilton Co

Location _____

Rig up _____

Drilling and Remarks:

Spud 4-20-50

10" @ 563

drile. 1370

RECORD

Cased _____ in., _____ ft.

Sand _____

Gas _____

Oil _____

Total Depth _____

PRODUCTION

1st 24 hrs. Nat. _____

1st 24 hrs. after shot _____

Gas _____ Cu. Ft.

Dry Hole _____

Abandoned _____

Date

APR 26 1950 19 J. E. TYRA Scout

County Morton State KansasSec. 5 (Blk.) 33 (Sur.) 39W Map No.Operator Panhandle EasternWell No. 1-5 Farm AndersonElev. 3239 Location SW NE

COMPLETE

O

150 Ft. From S Line NE

150 Ft. From W Line Quarter

1st. Report

Completion OGI 11 1950Remarks Hugoton PoolKuhn Drllr. - Contr.Spudding Date 4-20-50

Drig. Data Gas well TD 2597

10" @ 563 7" @ 2337 TD 2597

Hol. 2350 Per. 2390-2405 Rider 2417-75

Fin. 2400-2530 Twoanda 2557

Comp. 869,000 gas Del. test

CORRECTION (Twp 23 to 33)

J. E. TYRA

Your first report show Twp 23S

Your completion shows Twp 33S

Advise

Sam

33 is correct.

33 is in Hamilton Co.

Scout Cards

Land Small Map

Land Wall Map

Trails

Forest Map

Forest Map

Misc.

OCT 19 1950

Orig. Data