


Stevens

Map No. _____ Sec. 5 Twp. 33 R. 38 ^WWell No. 1-Hoff FarmArgus Gas Company

NORTH

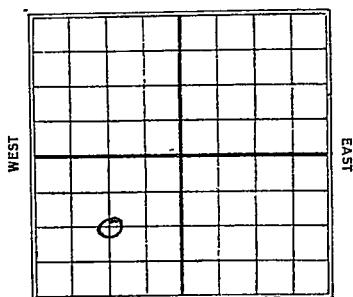

_____ Ft. from N. Line

1320 Ft. from S. Line

_____ Ft. from E. Line

1320 Ft. from W. Line

SOUTH

Date

REPORT

19308/27 Location9/3 Hdg. 500'9/10 " 1675'9/17 Assy 1675'9/24 Skidded Pipe
Drlg 550' (new hole)10/1 No report10/18 Drlg 2020'10/22 T.D. 2460' Rust10/29 —11/3 —11/12 Sand 2460-275011/19 T.D. 27502 1/2 ft Gas
Comp.

KANSAS

Map No. _____ Sec. 5 Twp. 33 R. 38
 Well No. 1 Hoff
Argus Gas Co Company
 Contractor

FIRST REPORTS**SECTION PLAT**

_____ Ft. from N. Line
1320 Ft. from S. Line
 _____ Ft. from E. Line
1320 Ft. from W. Line

Location _____

Rig up _____

Drilling and Remarks: _____

RECORD

Cased _____ in. _____ ft.

Sand _____

Gas _____

Oil _____

Total Depth _____

PRODUCTION

1st 24 hrs. Nat. _____

1st 24 hrs. after shot _____

Gas _____ Cu. Ft.

Dry Hole _____

Abandoned _____

Date

AUG 27 1930

19

CHAS. L. SHERWOOD

Scout


Map No. KANSAS Sec. 5 Twp. 33 R. 38W

Well No. 1

Argue Gas Company

Contractor

SECTION PLAT

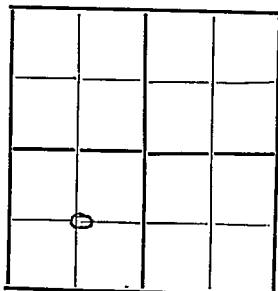

.....Ft. from N. Line

1820 Ft. from S. Line

.....Ft. from E. Line

1320 Ft. from W. Line

COMPLETED

Location

Rig up

Drilling and Remarks:

RECORD

Cased ³..... in., ft.

Sand 2460 - 2750

Gas 2 1/2 M.

Oil

Total Depth 2750

PRODUCTION

1st 24 hrs. Nat.

1st 24 hrs. after shot

Gas Cu. Ft.

Dry Hole

Abandoned

Date

NOV-19 1930

S. J. LEWIS Scout