

12-33-6W

(Please note that this report has been completed under the actual name of the well, which is Wethington, and not Wentington.)

FORM C-10


SEP 10 1972



KANSAS CORPORATION COMMISSION  
WELL RECORD

(Mail to Kansas Geological Survey, 4150 Monroe Street, Wichita, Kansas 67209)

API # 15-077-20,155

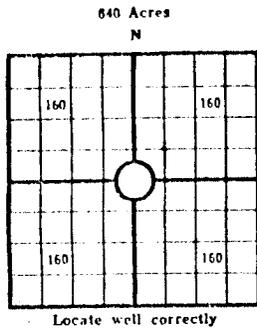

Lease Name: Wethington Well No. 1  
Well Located: C NE NW  
Harper Co. SEC 12 TWP 33 RGE 6w  
Operator: J. A. Allison  
Address: 1415 Wichita Plaza Bldg., Wichita, Ks.  
Elevation: Ground 1341 D.F. 1344 K.B. 1346  
Type Well: (Oil, gas, dry hole) P 12 BOPD + 20 BOPD / Lemo.

Drilling Commenced: June 15 1972 Drilling Completed: July 1 1972  
Well Completed: July 13 1972 Total Depth 4844  
Initial Production: 6 bbl in 4 hrs

Casing Record

Size: 8 5/8 Set at 247 Size: \_\_\_\_\_ Set at \_\_\_\_\_  
Size: 5 1/2 Set at 3850.82 Size: \_\_\_\_\_ Set at \_\_\_\_\_

Liner Record

Size: \_\_\_\_\_ Set from \_\_\_\_\_ To \_\_\_\_\_

Cementing

Casing Size	Sacks	Type Cement and Additives
<u>8 5/8</u>	<u>190</u>	<u>common, 3% CC, 2% gel</u>
<u>5 1/2</u>	<u>175</u>	<u>Portland w/3900# salt</u>

Perforations

Formation	Perforated Interval and Number Shots
<u>Kansas City</u>	<u>4 DP/ft 3770-72 &amp; 3771-73</u>
_____	_____
_____	_____

Electric Log Run (Show type log and depths covered)

Radiation-Guard - 20-4837'  
Porosity Plot - 20-4837'

(Fill in formation and related information on reverse side)

12-33-6W

## FORMATION, TESTING AND COMPLETION RECORD

Formation	Top	Bottom	Show Drill Stem Tests, Well Stimulation and Production Tests
Stalnaker	3519	3753	DST #1 - 3764-87 GTS 40 min
Kansas City	3753	4001	DST #2 - 3904-35 Rec 10' mud sp oil
B Kansas Cty	4001	4200	DST #3 - 4401-20 Rec 30' mud/ few sp oil
Cherokee	4200	4315	
Mississippi	4315	4714	7/12/72 & 8/16/72 - MCA in Annulus
Chattanooga			
Misener			
Viola	4809	4822	
Simp Dolo	4822	4834	
Simp Sand	4834	4845	
TD	4845		

DRILLER LOG

No. 1 Wethington  
Wethington

CASING RECORD:	COMPANY: Jim Allison	DESCRIPTION:
8 5/8" @ 247' w/190 sx cement	CONTRACTOR: Red Tiger Drilling Co.	NE NW 12-33S-6W Happer County, Kansas
5 1/2" @ 3850.82' w/175 sx cement	COMMENCED: June 15, 1972	ELEVATION:
TOTAL DEPTH: 4844'	COMPLETED: July 1, 1972	

<u>FORMATION</u>	<u>FROM</u>	<u>TO</u>	<u>REMARKS</u>
Red & Blue Shale	0	175	
Red Rock	175	247	
Red Beds	247	500	
Shale & Shells	500	710	
Shale	710	1029	
Lime & Shale	1029	1825	
Shale & Lime Shells	1825	2025	
Shale & Lime	2025	3493	
Lime	3493	3519	
Sand	3519	3582	
Shale & Lime	3582	3720	
Lansing Kansas City	3720	3787	
Lime	3787	4000	
Lime & Shale	4000	4140	
Lime	4140	4195	
Lime & Shale	4195	4240	
Lime	4240	4375	
Shale & Lime	4375	4423	
Lime	4423	4470	
Miss	4470	4540	
Lime	4540	4640	
Miss	4640	4710	
Lime & Shale	4710	4735	
Kinderhook	4735	4820	
Dolomite	4820	4824	
Simpson	4824	4844	



I certify that this is a true and correct copy of the above log to the best of my knowledge.

RED TIGER DRILLING COMPANY