


WELL LOG BUREAU—KANSAS GEOLOGICAL SOCIETY
508 East Murdock, Wichita, Kansas

13-33-6W

Company- THE TEXAS COMPANY
Farm- Harrison No. 1

SEC. 13 T. 33 R. 6W
NE NW NW

Total Depth. 5033
Comm. 1-31-55 Comp. 2-27-55
Shot or Treated.
Contractor. Stickle Drlg.
Issued. 4-9-55

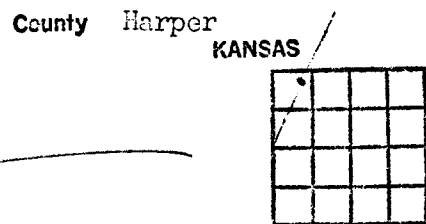

CASING:
10 3/4" 501 cem. w/500 sx.

Elevation. 1339 D.F.

Production. Dry

Figures indicate Bottom of Formations.

sand, shale, shells	350
red bed & shells	501
sand & shale	950
Anhyd.	965
shale & shells	1100
lime & shale	1655
shale & shells	1800
shale & lime	1960
shale & shells	2380
lime & shale	2507
shale & lime	2643
shale	2720
lime & shale	2855
shale & lime	3000
shale & shells	3122
shale & lime	3326
shale & sand	3573
lime & shale	3620
shale	3735
shale & lime	3767
lime	3959
shale & lime	4261
shale & lime	4315
lime & shale	4358
shale & lime	4367
hrd sand & lime	4387
lime	4722
shale	4805
sand	4831
hrd sand	4837
sand	4895
sand & shale	4940
shale	4957
sand	4980
sand & lime	4999
lime	5033
Total Depth	

Heebner	3103
Toronto	3136
Stalnaker	3504
Kansas City	3738
Base Kansas City	3967
Marmaton	4040
Cherokee	4176
Miss.	4362
Kinderhook	4712
Simpson Dolo.	4794
Simpson-sand	4814
Simpson-shale	4888
Lower Simpson sand	4968
Arbuckle	4984

Tops:
Penn. Permian 2147
Severy 2642
Topeka 2716