

State Geological Survey
WICHITA BRANCH

KANSAS DRILLERS LOG

API No. 15 — 077 — 20,259
County Number

Operator

Stelbar Oil Corporation, Inc.

Address 200 West Douglas, Suite 950
Wichita, Kansas 67202

Well No.

#3

Lease Name

Meineke

Footage Location

660

feet from ~~750~~ (S) line

660

feet from ~~750~~ (W) line

Principal Contractor

Graves Drilling Co.

Geologist

Charles R. King

Spud Date

April 23, 1974

Total Depth

4544

P.B.T.D.

Date Completed

May 1, 1974

Oil Purchaser


none

S. 26 T. 33 R. 6 ~~E~~ W

Loc. C SW SW

County Harper

640 Acres

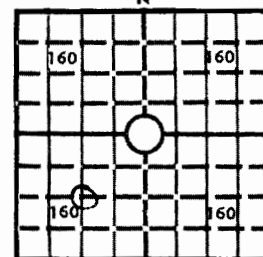

Locate well correctly

Elev.: Gr. 1304

DF 1306 KB 1309

CASING RECORD

Report of all strings set — surface, intermediate, production, etc.

Purpose of string	Size hole drilled	Size casing set (in O.D.)	Weight lbs/ft.	Setting depth	Type cement	Sacks	Type and percent additives
Surface	12 1/4"	8-5/8"		209		190	2% Gel, 3% CC
SWD String		5-1/2"		3674		100	

LINER RECORD

PERFORATION RECORD

Top, ft.	Bottom, ft.	Sacks cement	Shots per ft.	Size & type	Depth interval

TUBING RECORD

Size	Setting depth	Packer set at			

ACID, FRACTURE, SHOT, CEMENT SQUEEZE RECORD

Amount and kind of material used	Depth interval treated

INITIAL PRODUCTION

Date of first production none	Producing method (flowing, pumping, gas lift, etc.)				
RATE OF PRODUCTION PER 24 HOURS	Oil bbls.	Gas MCF	Water bbls.	Gas-oil ratio	CFPB
Disposition of gas (vented, used on lease or sold)			Producing interval (s)		

INSTRUCTIONS: As provided in KCC Rule 82-2-125, within 90 days after completion of a well, one completed copy of this Drillers Log shall be transmitted to the State Geological Survey of Kansas, 4150 Monroe Street, Wichita, Kansas 67209. Copies of this form are available from the Conservation Division, State Corporation Commission, 3830 So. Meridian (P.O. Box 17027), Wichita, Kansas 66217. Phone AC 316-522-2206. If confidential custody is desired, please note Rule 82-2-125. Drillers Logs will be on open file in the Oil and Gas Division, State Geological Survey of Kansas, Lawrence, Kansas 66044.

DESIGNATE TYPE OF COMP.: OIL, GAS,
DRY HOLE, SWDW, ETC.:


Well No. 3	Lease Name Meineke	SWDW
S <u>26</u> T <u>33</u> S <u>R 6</u> ^K W		


**SHOW GEOLOGICAL MARKERS, LOGS RUN,
OR OTHER DESCRIPTIVE INFORMATION.**

Show all important zones of porosity and contents thereof; cored intervals, and all drill-stem tests, including depth interval tested, cushion used, time tool open, flowing and shut-in pressures, and recoveries.

FORMATION DESCRIPTION, CONTENTS, ETC.	TOP	BOTTOM	NAME	DEPTH
Red bed, sand & shale	0	209		
Red bed	209	300		
Red bed & shale	300	1055		
Shale & lime	1055	1445		
Lime	1445	1651		
Lime & shale	1651	1925		
Shale & lime	1925	3293		
Shale & sand	3292	3527		
Sand & shale	3527	3650		
Shale & lime	3650	3891		
Lime	3891	4055		
Lime & shale	4055	4324		
Shale & lime	4324	4445		
Lime	4445	4470		
Chert, dolomite & lime	4470	4530		
Lime	4530	4544		
Rotary Total Depth	4544			
Geological formation tops as picked from samples, and the open hole survey, are tabulated below. All measurements are from the rotary bushing elevation, 1309.				
Chase Group	1277	(+32)		
Heebner	3166	(-1857)		
Douglas	3205	(-1896)		
Iatan	3521	(-2212)		
Stalnaker	3558	(-2249)		
Base Stalnaker	3624	(-2315)		
Kansas City	3801	(-2492)		
Base Kansas City	4090	(-2781)		
Marmaton	4113	(-2804)		
Cherokee	4243	(-2934)		
Mississippi "Chat"	4442	(-3133)		
Mississippi "Lime"	4468	(-3159)		
RTD	4544	(-3235)		
LTD	4539	(-3230)		

USE ADDITIONAL SHEETS, IF NECESSARY, TO COMPLETE WELL RECORD.

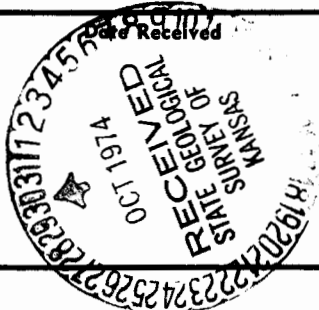

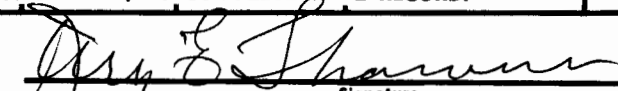
Signature
President
Title
September 13, 1974
Date

R O T A R Y D R I L L E R S ' L O G

26-33-6W

APF # 15-077-20,259

OPERATOR: Stelbar Oil Corporation, Inc.
200 West Douglas, Suite 950
Wichita, Kansas 67202

DRILLING COMMENCED: April 23, 1974

CONTRACTOR: Graves Drilling Co., Inc.
505 Union Center
Wichita, Kansas 67202

DRILLING COMPLETED: May 1, 1974

CASING RECORD: 5 Jts. 209' 8-5/8"
cemented with 190 sacks
119 Jts. 3679' 5-1/2"
cemented with 100 sacks

LOCATION: Meineke No. 3
C SW SW
Section 26-33S-6W
Harper County, Kansas

0 - 209 Red bed, sand & shale
209 - 300 Red bed
300 - 1055 Red bed & shale
1055 - 1445 Shale & lime
1445 - 1651 Lime
1651 - 1925 Lime & shale
1925 - 3293 Shale & lime
3293 - 3527 Shale & sand
3527 - 3650 Sand & shale
3650 - 3891 Shale & lime
3891 - 4055 Lime
4055 - 4324 Lime & shale
4324 - 4445 Shale & lime
4445 - 4470 Lime
4470 - 4530 Chert, dolomite & lime
4530 - 4544 Lime

4544 Rotary Total Depth



RECEIVED
STATE CORPORATION COMMISSION
MAY 3 - 1974
CONSERVATION DIVISION
Wichita, Kansas

I hereby certify the foregoing statements to be true and correct to the best of