


Section 35 Township 33 Range 6W

Well No. #1 Hoopes

Company Cities Service

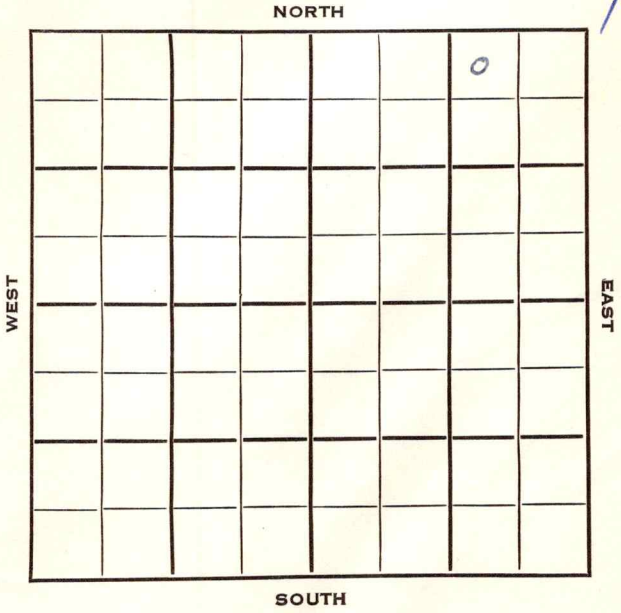

Harper

SEC. 35	TWP. 33	R. KANSAS 6W ✓
---------	---------	-----------------------------------------------------------------------

WELL NO. #1 Hoopes FARM

COMPANY Cities Service


CONTRACTOR Wildcat.

330 _____ Ft. from N. Line

_____ Ft. from S. Line

990 _____ Ft. from E. Line

_____ Ft. from W. Line

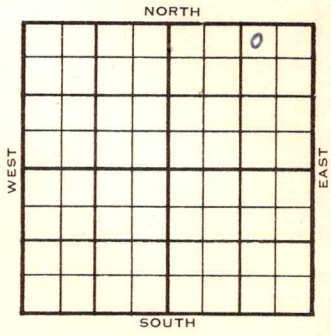

NW NE NE

	ELEVATION	REPORT
1954	1257'	
2/3	Location	
2/24	10" @ 340'	Drlg 2460'
3/3	Top 2747', Doug 3221'	Drlg 3955'
3/10	Lans 3456', Stal 3462', KC 3745', B KC 3994', Miss 4453'	∅ 4463'-65'
3/17	DST 4450'-65' 40 Mins 55' M 1420#	DST 4465'-77' 1 hr, 65' M 120' M & SW 180' SW, 1651#
3/24	Kh. 4817', V. 4846', Simp 4849'	DST 4848'-58' 40 mins, 1740' SW 2010#
	Drlg 4964'	

OVER

1954
3/31

Spud 2-17554 D & A TD 5172
10" @ 340 Top. 2663 Doug. 3221
Lans. 3456 Stal. 3462 KC 3745
B KC 3994 Miss. 4453
DST 4450-65 open 40 min rec 55' mud
1420#
DST 4465-77 open 1 hr rec 65' mud,
120' mud & SW, 180' SW 1651# **KK.**
Kh. 4817' Viola 4846 Simp. 4849
DST 4848-58 open 40 min rec 1740'
SW 2010# **Arb. 5057**
TD 5172' D & A

ABANDONED

