


Section 13 Township 33 Range 6 W

Well No. # 1 J. B. Harrison

Company Texas Company

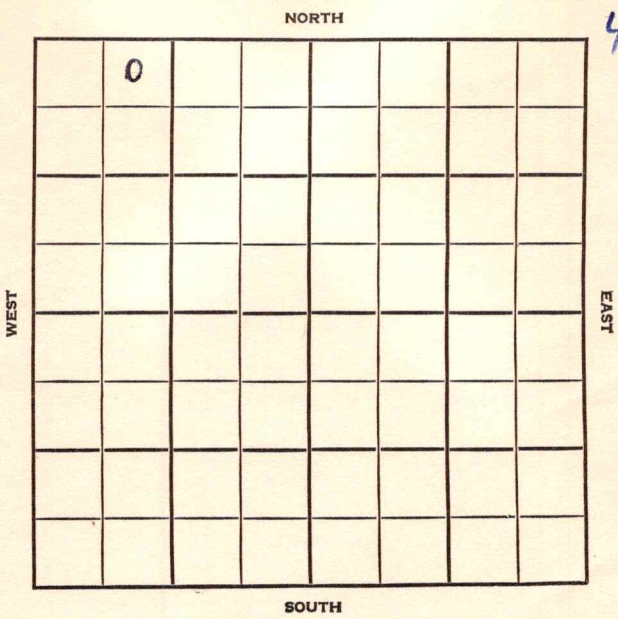

Harper KANSAS

SEC. 13 TWP. 33 R. 6W

WELL NO. 1 J. B. Harrison FARM COMPANY

CONTRACTOR Texas Co.

Stickle Drlg.  
Wildcat


330 Ft. from N. Line

Ft. from S. Line

Ft. from E. Line

990 Ft. from W. Line

NE NW NW

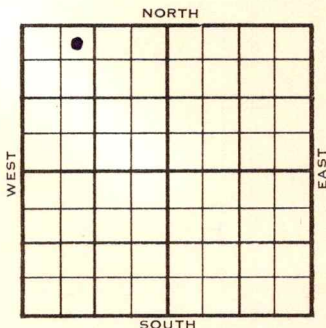

	ELEVATION	REPORT
1955	1339'	

2/2 Spud 1-31-55  
RUR

3/2 Spud 1-31-55 D & A TD 5033'  
10" @ 501 Heeb 3088 Tor 3116  
KC 3762' B KC 3968' Cherokee 4185  
Miss 4367  
DST 4446-56 open 1 hr rec 25' drlg.  
mud. 62#  
DST 4453-72 open 1½ hr rec 75' drlg mud  
425# Kh. 4710 Simp 4801 Simp sd  
4816'  
DST 4800-25 open 1 hr rec 3050' SW.  
Arb. 4987' TD 5033' D & A

**ABANDONED**

County **Harper** State **Kansas**

Sec. **13** (Blk.) **33** (Sur.) **6W** Map No.

Operator **Texas Company**

Well No. **1** Farm **J. B. Harrison**

Elev. Location **NE NW NW**

0				
FIRST REPORT				

**330** Ft. From **N** Line **NW**

**990** Ft. From **W** Line **Quarter**

1st. Report **FEB 2 1955**

Completion

Remarks

**Stickle Drlg. - Contr.**

Spudding Date **1-31-55**

Drlg. Data **Wildcat**

**RUR**

FABEN GILSTRAP

County Harper State Kansas

Sec. 13 (Blk. 33 (Sur. Rge.) 6W Map No.

Operator Texas Company

Well No. 1 Farm J. B. Harrison

Elev. 1339 Location NE NW NW

0					

330Ft. From N Line NW

990Ft. From W Line Quarter

1st. Report

Completion MAR 2 1955

Remarks Wildcat

Stickle Drlg. - Contr.

Spudding Date 1-31-55

Drlg. Data D & A TD 5033

10" @ 501 Heeb. 3088 Tor. 3116

KC 3762 B KC 3968 Cherokee 4185

Miss. 4367 DST 4446-56 open 1 hr.

Rec. 25' drlg. mud 62# DST 4453-72

open 1 1/2 hr. Rec. 75' drlg. mud 425#

Kh. 4710 Simp. 4801 Simp. sd. 4816

DST 4800-25 open 1 hr. Rec. 3050' sw

Arb. 4987 TD 5033

D & A

FABEN GILSTRAP