


Map No. KANSAS Sec. 17 Twp. 33 R. 6W
Well No. 1- Wolff Farm
Kessler & their etc Company

NORTH

WEST

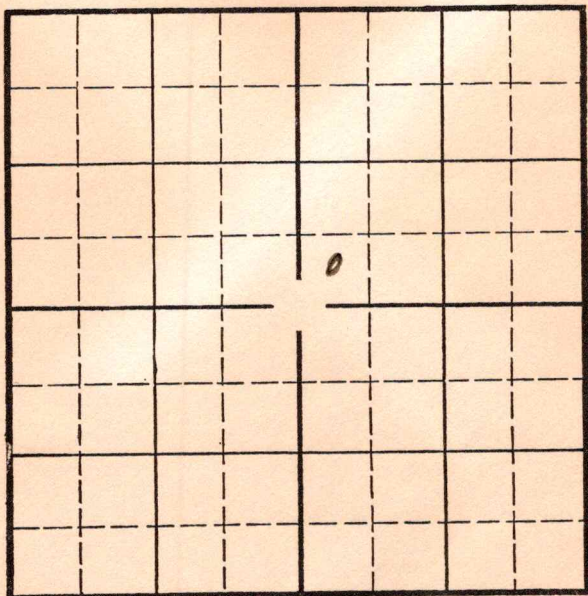

EAST

SOUTH

Location _____
Drilling Remarks _____

Rig Up _____
Drilling Remarks _____

RECORD


Cased _____ in. _____ ft.
Sand _____
Gas _____
Oil _____
Total Depth _____

PRODUCTION

1st 24 hrs. Nat. _____
1st 24 hrs. after shot _____
Gas _____ cu. ft. _____
Dry Hole _____
Abandoned _____

Map No. KANSAS Sec. 17 Twp. 33 R. 6W
Well No. 1-Wolfe Farm
Kessler & Thier etc. Company

NORTH

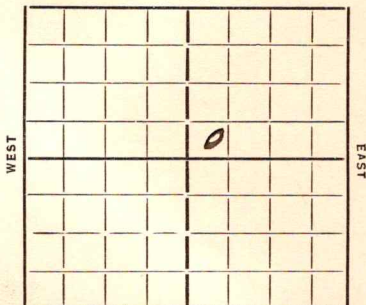

SOUTH

Ft. from N. Line

330 Ft. from S. Line

Ft. from E. Line

330 Ft. from W. Line

Elev. 1326

REPORT

Date 7/25
5/28 Moving In
6/6 Rig
6/13 6/20 -
6/28 Spud
7/3 1670 15 1/2 40
7/11 " 2890
7/18 " 3910
8/8 Chat 4403 BML 4735
Coy 4840
8/15 Wib 4854 Gas 4874-75
8/22 4901
8/28 Sil 5011 Coing
T D 5078
Dr. Ft.

ABANDONED

5011

1326

3685

Map No. *K32* Sec. *17* Twp. *33* R. *6 N*

Well No. *1-Wolfe*

Kessler & Thier et al Company

Contractor

FIRST REPORTS

SECTION PLAT

		0	

Ft. from N. Line

330 Ft. from S. Line

Ft. from E. Line

330 Ft. from W. Line

Location

Rig up

Drilling and Remarks:

Moving in

RECORD

Cased in., ft.

Sand

Gas

Oil

Total Depth

PRODUCTION

1st 24 hrs. Nat.

1st 24 hrs. after shot

Gas Cu. Ft.

Dry Hole

Abandoned

Date

ORVAL MANNSCHRECK

5-28-35 192

Scout

KANSAS

Map No. 32 Sec. 17 Twp. 33 R. 6W

Well No. 1- Wolfe

Kessler + Thier et al Company

Contractor

ABANDONED

SECTION PLAT

		0	

Ft. from N. Line

330 Ft. from S. Line

Ft. from E. Line

330 Ft. from W. Line

ABANDONED

Location

Rig up

Drilling and Remarks:

10 + H

RECORD

Cased in., ft.

Sand Sil 5011

Gas

Oil

Total Depth 5078

PRODUCTION

1st 24 hrs. Nat.

1st 24 hrs. after shot

Gas Cu. Ft.

Dry Hole

Abandoned

Date

8-28-35 192

ORVAL MANNSCHECK Scout