


Section 6 Township 33 Range 43W
Well No. 1 U. S. A. Brown Unit
Company Amerada Petr.

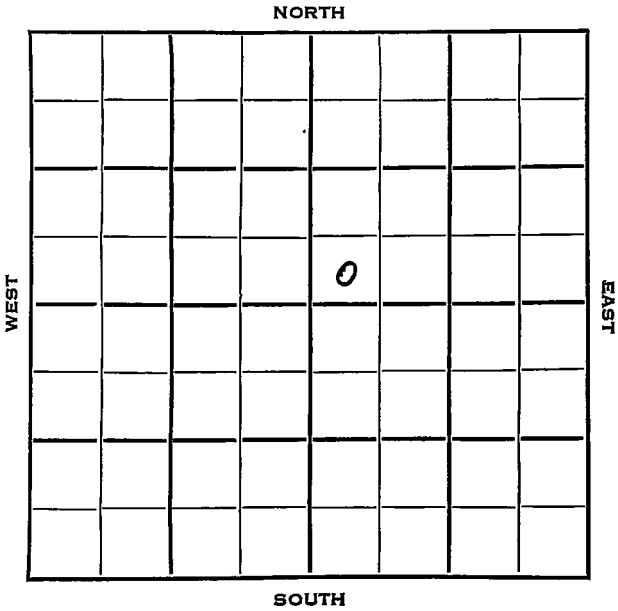

Morton

KANSAS

SEC.	6	TWP.	33	R.	43 W	✓
WELL NO.	# 1 U.S.A. Brown Unit					
COMPANY	FARM					

Amerada Pet.

CONTRACTOR

Peel Bros.

Greenwood Pool


Ft. from N. Line

330 Ft. from S. Line

Ft. from E. Line

330 Ft. from W. Line

SW SW NE

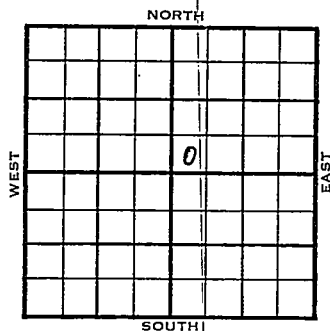

	ELEVATION	REPORT
1954	3655'	
3/10	Spud 3-9-54 Anhy 580' Drlg. 615'	
3/17	8" @ 610' Drlg 2655'	
4/14	Spud 3-9-54 as Well TD 3350' Anhy 580' 8" @ 610' Blaine 855', Neva 2564', Top 2934', Lans 3199' TD 3350' 5" @ 3340' CO to 3314, 72/3074-92, $\frac{1}{4}$ mcfg, 5000A 3,355,000 gas, SP 3055, 268/2978-3045, 5000A 4,162,000 2000A, CO to 3313, 10,000A 4,744,000 gas Comp. 8,829,000 gas, 440#	

COMPLETED

County **Morton** State **Kansas**

Sec. 6 (Blk. Twp.) 33 (Sur. Rge.) 43W Map No.

Operator Amerada Pet.

Well No. **1** Farm **U.S.A. Brown Unit**

Elev.	Location	SW	SW	NE
-------	----------	----	----	----

330 Ft. From S Line NE

330	Ft. From	Line	Quarter
-----	----------	------	---------

1st. Report MAR 10 1954

Completion


Remarks

Peel Bros. - Contr.

Spudding Date **3-9-54**

Drig. Data Greenwood Pool

Anhy 580 drlg. 615

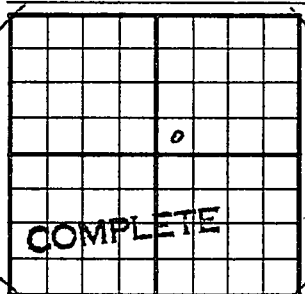County Morton State KANSASSec. 6 (Blk. Twp.) 33 (Sur. Rge.) 43W Map No.Operator Amerada Pet.Well No. 1 Farm U.S.A. Brown UnitElev. 3655 Location SW SW NE330 Ft. From S Line NE330 Ft. From W Line Quarter

1st. Report

Completion APR 14 1954Remarks Greenwood PoolPeel Bros. - Contr.Spudding Date 3-9-54Drig. Data Gas well TD 3350Anhy 580 8" @ 610 Blaine 855Neva 2564 Top. 2934 Lans. 3199TD 3350 5" @ 3340 CO. to 331472/ 3074-92 $\frac{1}{2}$ mcf/g 5000 A 3,355,000 gasSP 3055 268/ 2978-3045 5000 A4,162,000 2000 A CO to 3313 10,000 A4,744,000 gas Comp. 8,829,000 gas 440#

J. G. McGEHEE