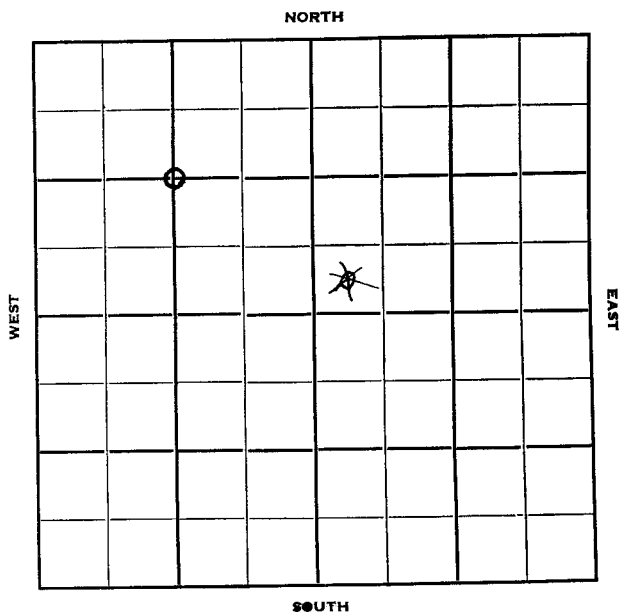


Section 6 Township 33 Range 33-W
Well No. #1 Jerman
Company Cabot Carbon



Seward

6

33

33-W

Sec. _____ Twp. _____ R. _____

#1 Jerman

Well No. _____ Farm _____

Cabot Carbon

Company

Contractor

Hugoton

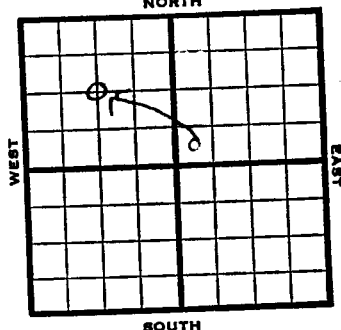
NORTH

1320 Ft. from N. Line

330 Ft. from S. Line

Ft. from E. Line

330/320 Ft. from W. Line



SW SW NE

C W W / 4

1951

Elv. 2859'

REPORT

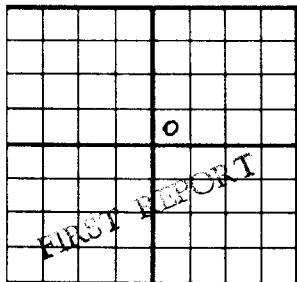
1/3

Location

3/28

Gas Well ED 2665
10" @ 465' 7" @ 2460
TD 2665'
Per. 2555' Krider 2580
Min. 2656'
SP 2662 18,000 A
Comp. 14,944,000 gas 425#

COMPLETED

County Seward State KansasSec. 6 (Blk. Twp.) 33 (Sur. Rge.) 35W Map No.Operator Cabot CarbonWell No. 1 Farm JermanElev. Location SW SW NE330 Ft. From S Line NE330 Ft. From W Line Quarter1st. Report JAN 3 1951

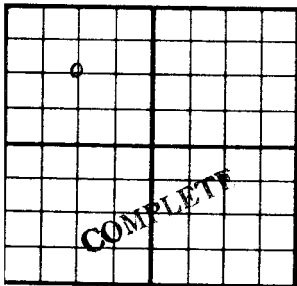
Completion

Remarks

Spudding Date

Orig. Data Hugoton PoolLocation

J. E. TYRA

County Seward State KansasSec. 6 (Blk.
Twp.) 33 (Sur.
Rge.) 33W Map No.Operator Cabot CarbonWell No. 1 Farm JermanElev. 2859 Location C NW/41320 Ft. From N Line NW1320 Ft. From W Line Quarter

1st. Report

Completion MAR 2 1951Remarks Hugoton PoolSpudding Date 1-12-51Drig. Data Gas well TD 266510" @ 465 7" @ 2560 TD 2665Her. 2555 Krider 2580 Win. 2656SP 2662 18000 A Comp. 14,944,000 gas
425#

Kansas

Map No. _____ Sec. 6 Twp. 33 R. 33WWell No. 1 JermanCabot Carbon

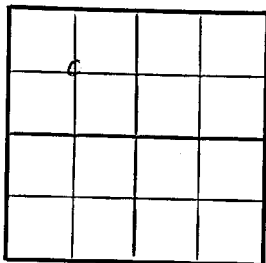
Company

CORRECTION

Contractor

C NW/4

SECTION PLAT

1320 Ft. from N. Line

_____ Ft. from S. Line

_____ Ft. from E. Line

1320 Ft. from W. LineSeward County

Location _____

Rig up _____

Drilling and Remarks:

Reported

SW SW NE

RECORD

Cased _____ in., _____ ft.

Sand _____

Gas _____

Oil _____

Total Depth _____

PRODUCTION

1st 24 hrs. Nat. _____

1st 24 hrs. after shot _____

Gas _____ Cu. Ft.

Dry Hole _____

Abandoned _____

Date

JAN 17 1951J. E. TYRA Scout