
FORM 51 25M 8-50 WESTERN Seward

Section 6 Township 33 Range 33W

Well No. #1 Marsh

Company Veeder Supply

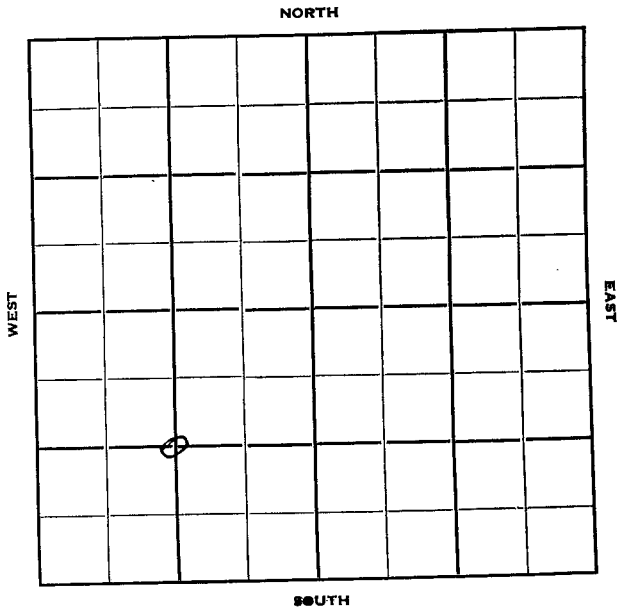

FORM 252-B
10M 11-50 PETROL

Seward KANSAS

Sec. 6 Twp. 33 R. 33W

Well No. #1 Marsh Farm

Veeder Supply Company

Contractor


Ft. from N. Line

1320' Ft. from S. Line

Ft. from E. Line

1320' Ft. from W. Line

C SW

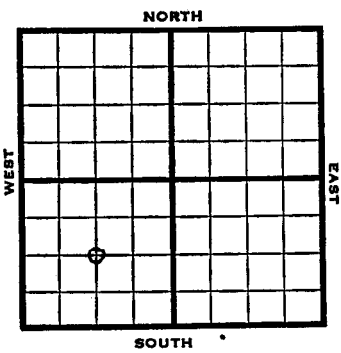

1951	Elev. 2681' REPORT
6/20	Spud 6-16-51 10" @ 442 Drlg. 692'
7/25	Spud 6-16-51 Gas Well TD 2640 10" @ 442 7" @ 2529 TD 2640 Krider 2570 Win. 2620 14,500 A Comp. 13,900,000 gas

COMPLETED

FORM 275 FOR SALE BY KANSAS BLUE PRINT CO.


County Seward State Kansas

Sec. 6 (Blk. Twp.) 33 (Sur. Rge) 33 W Map No.

Operator Veeder Supply

Well No. 1 Farm Marsh

Elev. Location C SW

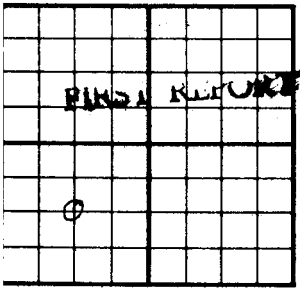

1320 Ft. From S Line SW

1320 Ft. From W Line Quarter

1st. Report JUN 20 1951

Completion

Remarks

Spudding Date 6-16-51

Drlg. Data Hugoton Pool

10" @ 442 Drlg. 692

J. E. TYRA

FORM 275 FOR SALE BY KANSAS BLUE PRINT CO.


County Seward State Kansas

Sec. 6 (Blk. Twp.) 33 (Sur. Rge.) 33W Map No.

Operator Veeder Supply

Well No. 1 Farm March

Elev. 2831 Location C SW/4

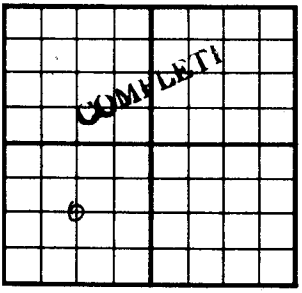

1320 Ft. From S Line SW

1320 Ft. From W Line Quarter

1st. Report

Completion JUL 25 1951

Remarks Hugoton Pool

Spudding Date 6-16-51

Drlg. Data Gas well TD 2640

10" @ 442 7" @ 2529 TD 2640

Krider 2570 Win. 2620 14500 A

Comp. 13,900,000 gas

J. E. TYRA