Harper


KANSAS

SECTION 3 TOWNSHIP 33 RANGE 7W

WELL NO. #1 Lewis Sechler

COMPANY Sinclair Oil & Gas

6

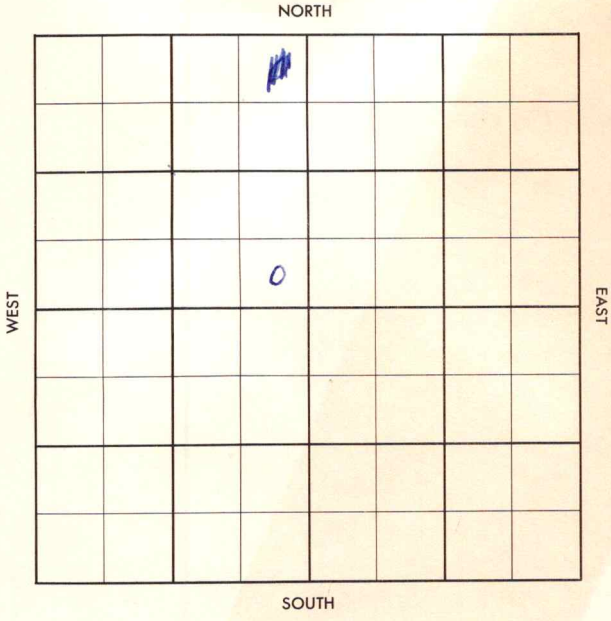

FORM 504-3 SUNRAY

Harper **KANSAS**

SEC.	TWP.	R.
3	S 33	7W

WELL NO.

#1 Lewis Sechler FARM

COMPANY

Sinclair Oil & Gas

CONTRACTOR


Barbour
S. Banner

_____ Ft. from N. Line

_____ Ft. from S. Line

_____ Ft. from E. Line

SE SE NW Ft. from W. Line

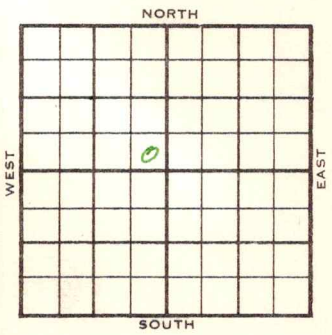

1956	ELEVATION 1388'	REPORT

5-9 RUR

6-6 Comm. 5-9-56
10" @ 271 w/250
DST 5070-98 op 1½ hrs. rec. 45' mud, ≠ 2700' SW, FP 30-150, BHP1845/20" Schl.
D & A
H. 3285', Sh. 3408', Stall 3605', KC. 3912', M. 4461', K. 4775', Chata 4845', V. 4888', S. 4904', A. 5067',
Log tops:H. 3288', Sh. 3407', Stall 3611', KC. 3914', M. 4480', Chata 4059', V. 4891', S. 4907', A. 5069',
TD 5100'.

ABANDONED

DX-78

FORM 513 SUNRAY

County Harper Elev.

Sec. 3 Twp. 33 Rge. 7W

Company Sinclair Oil & Gas

Farm Name Lewis Sechler No. 1

TOPS	DEPTH	LOG	DATUM
Anh.			
Tp.			
H.			
Tr.			
Dg.			
B.L.			
L.			
K.C.			
B.K.C.			
Ce.			
C.			
M.			
M.			
K.			
Mz.			
Mo.			
V.			
S.			
S.			
A			
R.			
P€.			
G.			
T.D.			

Loc. in Sec. SE SE NW

Geol.

Contr. Barbour

Pool S. Banner

0

FIRST REPORT

MAY 9 '55

Date Comm.

R U R

MAY 1 1 1955

R. G.

Co. Lse. No. Sec. T. R.

FORM 513 SUNRAY

County Harper Elev. 1388 Co.

Sec. 3 Twp. 33 Rge. 7W

Company Sinclair Oil & Gas

Farm Name Lewis Sechler No. 1

TOPS	DEPTH	LOG	DATUM
Anh.			
Tp.			
H.	3285	3288	
Tr.			
Dg. Sh.	3408	3411	
Bl. Stall	3605	3611	
L.			
K.C.	3912	3914	
B.K.C.			
Ce.			
C.			
M.	4461	4480	
M.			
K.	4775	4785	
Mz. Chalk	4845	4859	
Mo.			
V.	4888	4891	
S.	4904	4907	
S.			
A	5067	5069	
R.			
Pe.			
G.			
T.D.	5098	5100	

Loc. in Sec. SE SE NW

Geol.

Contr. Barbour

Lse.

Pool S. Banner

ABANDONED

JUN 6 1956

No.

Date Comm.

Sec.

RUR MAY 16 '56 5-9-56 10" C

271/250 ⌀ 3290 MAY 23 '56 ⌀ 4562

MAY 29 '56 ⌀ 4985 JUN 6 '56

DST 5070-98 op 1½ hrs Rec.

45' Mud + 270' SW. FP 30-150

BHP 1895/20.

Schl. D & A

T.

R.