

Harper

KANSAS

SECTION 4 TOWNSHIP 33 RANGE 7 W

WELL NO. #1 Henness

COMPANY Roland-Pelt (Dallas)

NORTH

7

WEST

EAST

				0			

SOUTH

Harper

KANSAS

SEC. 4	TWP. 33	R. 7W
-----------	------------	----------

WELL NO. #1 Henness FARM

COMPANY Roland - Pelt (Dallas)

CONTRACTOR Barbour

WILDCAT


_____ Ft. from N. Line

_____ Ft. from S. Line

_____ Ft. from E. Line

_____ Ft. from W. Line

~~SW SW NE~~ NW SW NE

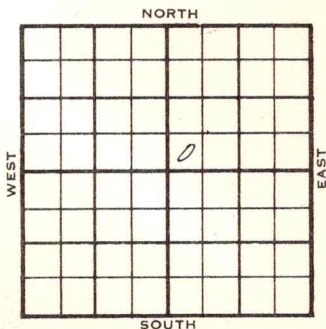

1955	ELEVATION 1372'	REPORT
------	--------------------	--------

11-23 Comm. 11-17-55
8" @ 234/225
Drlg. 2640.

1956

5-9 F/ 96 bo, 6 hrs., 12/4848-51
5 1/2" @ 4918
Comp. F/ 1408 bopd
K. 4748, Chatta 4820, Viola 4847'
TD 4918'

COMPLETED

County Harper Elev. _____
 Sec. 4 Twp. 33 Rge. 7W
 Company Roland-Pelt (Dallas)
 Farm Name Hennes No. 1

TOPS	DEPTH	LOG	DATUM
Anh.			
Tp.			
H.			
Tr.			
Dg.			
Bl.			
L.			
K.C.			
B.K.C.			
Ce.			
C.			
M.			
K.			
Mz.			
Mq.			
V.			
S.			
S.			
A.			
R.			
Pe.			
G.			
T.D.			

Loc. in Sec. SW SW NE

Geol. _____
 Contr. Barbour

Pool Wildcat

NOV 23 '55
 0
 FIRST REPORT

Date Comm. 11-17-55
8" @ 234/225 drlg. 2640

27

Co.
Lse.
No.
Sec.
T.
R.

County Harper Elev. 1372
 Sec. 4 Twp. 33 Rge. 7W
 Company Roland-Pelt (Dallas)
 Farm Name Henness No. 1

TOPS	DEPTH	LOG	DATUM	Loc. in Sec.
Anh.				NW SW NE
TP.				
H.				
Tr.				
Dg.				
BL.				
L.				Geol.
K.C.				Contr.
B.K.C.				Barbour
Ce.				
C.				Pool
M.				
M.				
K.	<u>4748</u>		<u>3376</u>	
Mz. <u>Chatta</u>	<u>4850</u>		<u>3448</u>	
Mg. <u>Viola</u>	<u>4847</u>		<u>3475</u>	
V.				
S.				
S.				
A.				
R.				
PE.				
G.				
TD.	<u>4918</u>			



Date Comm. 11-17-55 MAY 9 1956
 8" @ 234/225 F/ 96 bo 6 hr.

12/ 4848-51 5 1/2" @ 4918
 Comp. F/ 1408 bopd

Blank lines for additional data or notes.

CORRECTION

FORM 513 REV. SUNRAY

County Harper Elev. _____
Sec. 4 Twp. 33 Rge. 7W
Company Roland-Pelt
Farm Name Heness No. 1

TOPS	DEPTH	LOG	DATUM	Loc. in Sec.
Anh.				NW SW NE
TP.				
H.				
Tr.				
Dg.				
B.L.				
L.				Geol. _____
K.C.				Contr. _____
B.K.C.				
Ce.				
C.				
M.				Pool _____
M.				
K.				
Mz.				
Ma.				
V.				
S.				
S.				
A.				
R.				
Pe.				
G.				
T.D.				



Date Comm. Reported SW SW NE MAY 9 1956

Co.
Lse.
No.
Sec.
T.
R.