DX 78-1


Harper

KANSAS

Section 4 Township 33 Range 7 W

Well No. #1 Anna Stewart

Company Sinclair Oil & Gas

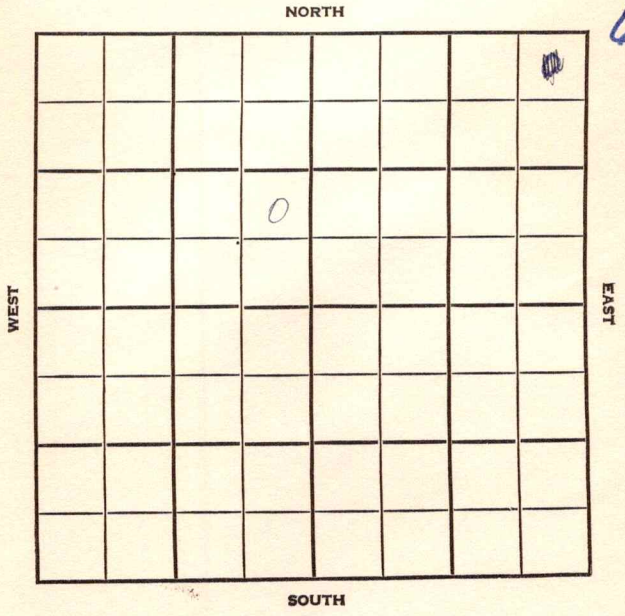

Harper KANSAS

SEC.	TWP.	R.
4	33	7W

WELL NO.

#1 Anna Stewart FARM

COMPANY

Sinclair Oil & Gas

CONTRACTOR

S. Banner


_____ Ft. from N. Line

_____ Ft. from S. Line

_____ Ft. from E. Line

_____ Ft. from W. Line

NE SE NW

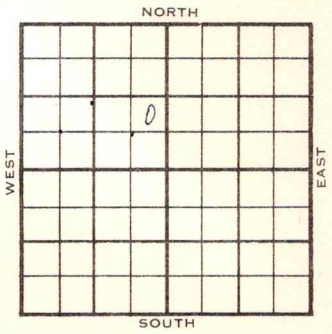

1956	ELEVATION 1365	REPORT
2-8	Loc.	
4-11	Comm. 2-15-56 10 3/4" @ 274 w/200 DST 4446-74 op 1 hr. rec. 60' mud, 412/30" DST 4845-59 op 1½ hr. gas in ## 3 min. F/ oil in 18 min. 1872/30" F/ 25 boph 5½" @ 4930/150 32/ 4845-53 F/ 17 boph, 7 hrs. Comp. F/ 237 bopd H. 3268 ##.Oread 3274 Heeb. 3285 Stal 3603 3590 KC 3894 3893 M. 4443 K. 4748 Mz. 4848 4846 V. 4856 4855 S. Sd 4873 4872 A. 5040 5038 TD 5065'	COMPLETED

DX-78

FORM 513 REV. SUNRAY

County Harper Elev.

Sec. 4 Twp. 33 Rge. 7W

Company Sinclair Oil & Gas

Farm Name Anna Stewart No. 1

TOPS	DEPTH	LOG	DATUM
Anh.			
T.P.			
H.			
Tr.			
Dg.			
B.L.			
L.			
K.C.			
B.K.C.			
Ce.			
C.			
M.			
M.			
K.			
Mz.			
Mg.			
V.			
S.			
S.			
A			
R.			
P€.			
G.			
T.D.			

Loc. in Sec. NE SE NW

Geol.

Contr.

Pool S. Banner

FEB 9 '56

FIRST REPORT

Date Comm.

Location

Co. Lse. No. Sec. T. R.

FORM 513 REV. SUNRAY

County Harper Elev. 1365

Sec. 4 Twp. 33 Rge. 7W

Company Sinclair Oil & Gas

Farm Name Anna Stewart No. 1

TOPS	DEPTH	LOG	DATUM
Anh.			
Tp.			
H.		3268	
Tr. Dread.	3374		1909
Dg. Heeb.	3385		1926
Bl. Stal.	3603	3590	2325
L.			
K.C.	3894	3893	2528
B.K.C.			
Ce.			
C.			
M.		4443	3078
M.			
K.		4748	3383
Mz.	4848	4846	3481
Mo.			
V.	4856	4855	3490
S. Sd.	4873	4872	3507
S.			
A	5040	5039	3674
R.			
P€.			
G.			
T.D.	5065		

Loc. in Sec. NE SE NW

Geol.

Contr.

Pool S. Banner



Date Comm. 2-15-56 APR 11 1956

10 3/4" @ 274/200 DST 4446-74

open 1 hr. rec. 60' mud 412/30"

DST 4845-59 open 1½ hr. gas in 3 min.

F/ oil in 18 min. 1872/30"

F/ 25 boph 5½" @ 4930/150 CO

32/ 4845-53 F/ 17 boph 7 hr.

Comp. F/ 237 bopd

Co. Lse. No. Sec. T. R.